


1 LOCATION OF WATER WELL: Fraction Near The Center of Section Number Township Number Range Number
 County: Edwards ¼ ¼ SW ¼ 10 T 24 S R 16 E/W

Distance and direction from nearest town or city street address of well if located within city?
 Approx. 1½ mile north and 1½ mile east of Belpre, KS

2 WATER WELL OWNER: Pauline Donovan Not Available
 RR#, St. Address, Box #: Route 1 - Box 49 Board of Agriculture, Division of Water Resources
 City, State, ZIP Code: Belpre, KS 67519 Application Number: 37103

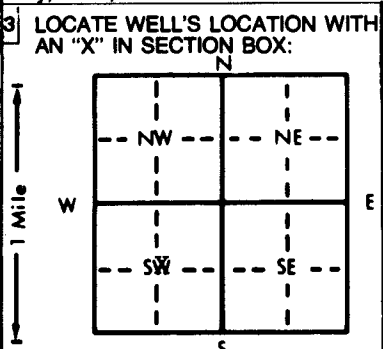

4 DEPTH OF COMPLETED WELL: 96 ft. ELEVATION: unknown
 Depth(s) Groundwater Encountered 1. 26.5 ft. 2. ft. 3. ft.
 WELL'S STATIC WATER LEVEL 26.5 ft. below land surface measured on mo/day/yr 12/12/86
 Pump test data: Well water was not ck'd ft. after hours pumping gpm
 Est. Yield 1000 gpm: Well water was ft. after hours pumping gpm
 Bore Hole Diameter .24 in. to .96 ft., and in. to ft.
 WELL WATER TO BE USED AS:
 5 Public water supply 8 Air conditioning 11 Injection well
 1 Domestic 3 Feedlot 6 Oil field water supply 9 Dewatering 12 Other (Specify below)
 2 Irrigation 4 Industrial 7 Lawn and garden only 10 Observation well
 Was a chemical/bacteriological sample submitted to Department? Yes.....No.....X.....; If yes, mo/day/yr sample was submitted
 Water Well Disinfected? Yes No X

5 TYPE OF BLANK CASING USED:
 1 Steel 3 RMP (SR) 5 Wrought iron 8 Concrete tile CASING JOINTS: Glued Clamped
 2 PVC 4 ABS 6 Asbestos-Cement 9 Other (specify below) Welded X
 7 Fiberglass Threaded
 Blank casing diameter 16 in. to 55 ft., Dia in. to ft., Dia in. to ft.
 Casing height above land surface 12 in., weight 36, 87 lbs./ft. Wall thickness or gauge No. 219
 TYPE OF SCREEN OR PERFORATION MATERIAL:
 1 Steel 3 Stainless steel 5 Fiberglass 8 RMP (SR) 10 Asbestos-cement
 2 Brass 4 Galvanized steel 6 Concrete tile 9 ABS 12 None used (open hole)
 SCREEN OR PERFORATION OPENINGS ARE:
 1 Continuous slot 3 Mill slot 5 Gauzed wrapped 8 Saw cut 11 None (open hole)
 2 Louvered shutter 4 Key punched 7 Torch cut 9 Drilled holes
 10 Other (specify) Doerr Bridge Slot
 SCREEN-PERFORATED INTERVALS: From 55 ft. to 95 ft., From ft. to ft.
 From ft. to ft., From ft. to ft.
 GRAVEL PACK INTERVALS: From 10 ft. to 95 ft., From ft. to ft.
 From ft. to ft., From ft. to ft.

6 GROUT MATERIAL: 1 Neat cement 2 Cement grout 3 Bentonite 4 Other
 Grout Intervals: From 0 ft. to 10 ft., From ft. to ft., From ft. to ft.
 What is the nearest source of possible contamination:
 1 Septic tank 4 Lateral lines 7 Pit privy 10 Livestock pens 14 Abandoned water well
 2 Sewer lines 5 Cess pool 8 Sewage lagoon 11 Fuel storage 15 Oil well/Gas well
 3 Watertight sewer lines 6 Seepage pit 9 Feedyard 12 Fertilizer storage 16 Other (specify below) FIELD
 Direction from well? all How many feet?

FROM	TO	LITHOLOGIC LOG	FROM	TO	LITHOLOGIC LOG
0	38	Topsoil - sandy tan & brown clay			
38	95	Sand & gravel, fine to medium to coarse, clean with a few thin clay streaks between 75'-80'			
95	96	Tan clay			

7 CONTRACTOR'S OR LANDOWNER'S CERTIFICATION: This water well was (1) constructed, (2) reconstructed, or (3) plugged under my jurisdiction and was completed on (mo/day/year) 12/12/86 and this record is true to the best of my knowledge and belief. Kansas Water Well Contractor's License No. 185 This Water Well Record was completed on (mo/day/yr) 12/16/86 under the business name of Clarke Well & Equipment, Inc. by (signature)

INSTRUCTIONS: Use typewriter or ball point pen. PLEASE PRESS FIRMLY and PRINT clearly. Please fill in blanks, underline or circle the correct answers. Send top three copies to Kansas Department of Health and Environment, Office of Oil Field and Environmental Geology, Regulation and Permitting Section, Topeka, Kansas 66620-7500, Telephone: 913-862-9360. Send one to WATER WELL OWNER and retain one for your records.

OFFICE USE ONLY