


1 LOCATION OF WATER WELL: Fraction near 1/4 C 1/4 SW 1/4 Section Number 15 Township Number T 24 S Range Number R 16 **EW**

Distance and direction from nearest town or city street address of well if located within city?  
1 1/2 east 1/2 north of Belpre, Ks.

2 WATER WELL OWNER: Ron Schultz  
 RR#, St. Address, Box #: Trousdale, Ks. 67145 Board of Agriculture, Division of Water Resources  
 City, State, ZIP Code: Application Number: 37,574

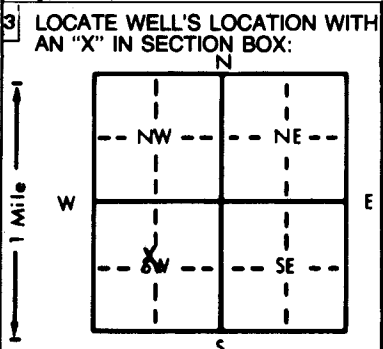

4 DEPTH OF COMPLETED WELL... 98 ft. ELEVATION: .....

Depth(s) Groundwater Encountered 1. .... ft. 2. .... ft. 3. .... ft.

WELL'S STATIC WATER LEVEL ..... 20 ft. below land surface measured on mo/day/yr 3-25-88

Pump test data: Well water was 47 1/2 ft. after 2 hours pumping 800 gpm  
 Est. Yield 1200 gpm: Well water was 52 ft. after 3 hours pumping 1100 gpm

Bore Hole Diameter... 29 in. to 98 ft., and... in. to... ft.

WELL WATER TO BE USED AS: 5 Public water supply 8 Air conditioning 11 Injection well  
 1 Domestic 3 Feedlot 6 Oil field water supply 9 Dewatering 12 Other (Specify below)  
2 Irrigation 4 Industrial 7 Lawn and garden only 10 Observation well

Was a chemical/bacteriological sample submitted to Department? Yes.....No...X.....; If yes, mo/day/yr sample was submitted

Water Well Disinfected? Yes hth No

5 TYPE OF BLANK CASING USED: 5 Wrought iron 8 Concrete tile CASING JOINTS: Glued...X...Clamped...  
 1 Steel 3 RMP (SR) 6 Asbestos-Cement 9 Other (specify below) Welded...  
2 PVC 4 ABS 7 Fiberglass Threaded...  
 Blank casing diameter ..... 16 in. to 58 ft., Dia ..... in. to ..... ft., Dia ..... in. to ..... ft.  
 Casing height above land surface... 12 in., weight SDR 32.5 lbs./ft. Wall thickness or gauge No. ....

TYPE OF SCREEN OR PERFORATION MATERIAL: 7 PVC 10 Asbestos-cement  
 1 Steel 3 Stainless steel 5 Fiberglass 8 RMP (SR) 11 Other (specify) .....  
 2 Brass 4 Galvanized steel 6 Concrete tile 9 ABS 12 None used (open hole)

SCREEN OR PERFORATION OPENINGS ARE: 5 Gauzed wrapped 8 Saw cut 11 None (open hole)  
 1 Continuous slot 3 Mill slot 6 Wire wrapped 9 Drilled holes  
2 Louvered shutter 4 Key punched 7 Torch cut 10 Other (specify) .....

SCREEN-PERFORATED INTERVALS: From... 58 ft. to 98 ft., From ..... ft. to ..... ft.  
 From ..... ft. to ..... ft., From ..... ft. to ..... ft.

GRAVEL PACK INTERVALS: From... 20 ft. to 98 ft., From ..... ft. to ..... ft.  
 From ..... ft. to ..... ft., From ..... ft. to ..... ft.

6 GROUT MATERIAL: 1 Neat cement 2 Cement grout 3 Bentonite 4 Other .....

Grout intervals: From... 0 ft. to 20 ft., From ..... ft. to ..... ft., From ..... ft. to ..... ft.

What is the nearest source of possible contamination:  
 1 Septic tank 4 Lateral lines 7 Pit privy 10 Livestock pens 14 Abandoned water well  
 2 Sewer lines 5 Cess pool 8 Sewage lagoon 11 Fuel storage 15 Oil well/Gas well  
 3 Watertight sewer lines 6 Seepage pit 9 Feedyard 12 Fertilizer storage 16 Other (specify below)  
 13 Insecticide storage ..... NONE.....

Direction from well? How many feet? .....

FROM	TO	LITHOLOGIC LOG	FROM	TO	LITHOLOGIC LOG
0	3	Sandy top soil			
3	6	Black clay			
6	18	Gray clay			
18	24	Brown clay			
24	28	/Brown sandy clay			
28	38	Sand and gravel			
38	40	Brown sandy clay			
40	62	Sand and gravel			
62	63	White and brown clay			
63	99	Sand and gravel			
99	110	Yellow and brown clay			

7 CONTRACTOR'S OR LANDOWNER'S CERTIFICATION: This water well was (1) constructed, (2) reconstructed, or (3) plugged under my jurisdiction and was completed on (mo/day/year) ..... 5-13-88 ..... and this record is true to the best of my knowledge and belief. Kansas Water Well Contractor's License No. .... 134 ..... This Water Well Record was completed on (mo/day/yr) ..... 7-5-88 ..... under the business name of Rosencrantz-Bemis by (signature) Judith Robinson

INSTRUCTIONS: Use typewriter or ball point pen. PLEASE PRESS FIRMLY and PRINT clearly. Please fill in blanks, underline or circle the correct answers. Send top three copies to Kansas Department of Health and Environment, Office of Oil Field and Environmental Geology, Regulation and Permitting Section, Topeka, Kansas 66620-7500, Telephone: 913-862-9360. Send one to WATER WELL OWNER and retain one for your records.

OFFICE USE ONLY