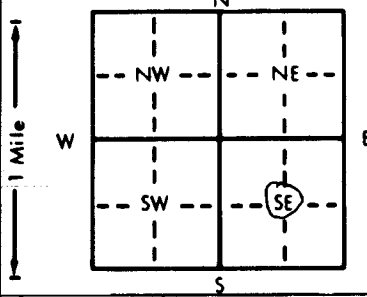


1 LOCATION OF WATER WELL: County: Edwards Fraction: center 1/4 NC 1/4 SE 1/4 Section Number: 16 Township Number: T 24 S Range Number: R 16 EW

Distance and direction from nearest town or city street address of well if located within city?  
1 1/2 miles east, 1/4 mile north of Belpre, KS

2 WATER WELL OWNER: S.J. Rudd  
 RR#, St. Address, Box #: 1918 Viewcrest Board of Agriculture, Division of Water Resources  
 City, State, ZIP Code: Dallas, TX 75228 Application Number: 38,612

3 LOCATE WELL'S LOCATION WITH AN "X" IN SECTION BOX:  


4 DEPTH OF COMPLETED WELL: 115 ft. ELEVATION: unknown  
 Depth(s) Groundwater Encountered 1. 40 ft. 2. 40 ft. 3. 40 ft.  
 WELL'S STATIC WATER LEVEL: 40 ft. below land surface measured on mo/day/yr  
 Pump test data: Well water was not ch'd ft. after XXXX hours pumping XXXX gpm  
 Est. Yield XX gpm: Well water was XXXX ft. after XXXX hours pumping XXXX gpm  
 Bore Hole Diameter: 24 in. to 114 1/2 ft., and XXXX in. to XXXX ft.  
 WELL WATER TO BE USED AS:  
 5 Public water supply 8 Air conditioning 11 Injection well  
 1 Domestic 3 Feedlot 6 Oil field water supply 9 Dewatering 12 Other (Specify below)  
 ② Irrigation 4 Industrial 7 Lawn and garden only 10 Monitoring well  
 Was a chemical/bacteriological sample submitted to Department? Yes.....No...X..... If yes, mo/day/yr sample was submitted  
 Water Well Disinfected? Yes No X

5 TYPE OF BLANK CASING USED:  
 1 Steel 3 RMP (SR) 5 Wrought iron 8 Concrete tile CASING JOINTS: Glued.....Clamped.....  
 2 PVC 4 ABS 6 Asbestos-Cement 9 Other (specify below) Welded X.....  
 7 Fiberglass Threaded.....  
 Blank casing diameter 16 in. to 115 ft., Dia. 42.05 in. to XXXX ft., Dia. XXXX in. to XXXX ft.  
 Casing height above land surface.....in., weight.....lbs./ft. Wall thickness or gauge No. 250  
 TYPE OF SCREEN OR PERFORATION MATERIAL:  
 1 Steel 3 Stainless steel 5 Fiberglass 8 RMP (SR) 10 Asbestos-cement  
 2 Brass 4 Galvanized steel 6 Concrete tile 9 ABS 11 Other (specify).....  
 12 None used (open hole)  
 SCREEN OR PERFORATION OPENINGS ARE:  
 1 Continuous slot 3 Mill slot 5 Gauzed wrapped 8 Saw cut 11 None (open hole)  
 2 Louvered shutter 4 Key punched 6 Wire wrapped 9 Drilled holes Doerr Slot  
 7 Torch cut 10 Other (specify).....  
 SCREEN-PERFORATED INTERVALS: From 75 ft. to 115 ft., From.....ft. to.....ft.  
 From.....ft. to.....ft., From.....ft. to.....ft.  
 GRAVEL PACK INTERVALS: From 20 ft. to 114 1/2 ft., From.....ft. to.....ft.  
 From.....ft. to.....ft., From.....ft. to.....ft.

6 GROUT MATERIAL: 1 Neat cement 2 Cement grout 3 Bentonite 4 Other.....  
 Grout intervals: From 0 ft. to 20 ft., From.....ft. to.....ft., From.....ft. to.....ft.  
 What is the nearest source of possible contamination:  
 1 Septic tank 4 Lateral lines 7 Pit privy 10 Livestock pens 14 Abandoned water well  
 2 Sewer lines 5 Cess pool 8 Sewage lagoon 11 Fuel storage 15 Oil well/Gas well  
 3 Watertight sewer lines 6 Seepage pit 9 Feedyard 12 Fertilizer storage 16 Other (specify below)  
 No Known Source  
 Direction from well? How many feet?

FROM	TO	LITHOLOGIC LOG	FROM	TO	PLUGGING INTERVALS
0	±0	sandy topsoil	XXXXXXXXXX	XXXXXXXXXX	
10	26	clay brown sandy	XXXXXXXXXX	XXXXXXXXXX	
26	31	fine sand			
31	44	clay green & brown sandy			
44	113	sand & gravel med to fine to coarse streak of clay @68'			
113	115	Clay brown & gray			

7 CONTRACTOR'S OR LANDOWNER'S CERTIFICATION: This water well was (1) constructed, (2) reconstructed, or (3) plugged under my jurisdiction and was completed on (mo/day/year) 11-23-88 and this record is true to the best of my knowledge and belief. Kansas Water Well Contractor's License No. 185 This Water Well Record was completed on (mo/day/yr) 12-5-88 under the business name of Clarke Well & Equipment Co., Inc. by (signature) Clarke Well & Equipment Co., Inc.

INSTRUCTIONS: Use typewriter or ball point pen. PLEASE PRESS FIRMLY and PRINT clearly. Please fill in blanks, underline or circle the correct answers. Send top three copies to Kansas Department of Health and Environment, Bureau of Water Protection, Topeka, Kansas 66620-7320. Telephone: 913-296-5514. Send one to WATER WELL OWNER and retain one for your records.

OFFICE USE ONLY  
T  
R  
EW  
SEC.