


1 LOCATION OF WATER WELL: Fraction Near the Center Section Number Township Number Range Number  
 County: Edwards 1/4 1/4 NE 1/4 17 T 24 S R 16 EW

Distance and direction from nearest town or city street address of well if located within city?  
 Approximately 3/4 mile north of Belpre, KS

2 WATER WELL OWNER: Dennis Dutton  
 RR#, St. Address, Box #: Rural Route Board of Agriculture, Division of Water Resources  
 City, State, ZIP Code: Macksville, KS 67557 Application Number: 39,495

3 LOCATE WELL'S LOCATION WITH AN "X" IN SECTION BOX:

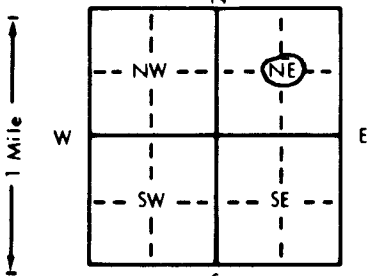

4 DEPTH OF COMPLETED WELL: 88 ft. ELEVATION: unknown  
 Depth(s) Groundwater Encountered 1. ft. 2. ft. 3. ft.  
 WELL'S STATIC WATER LEVEL: 28 ft. below land surface measured on mo/day/yr  
 Pump test data: Well water was not ch'd ft. after hours pumping gpm  
 Est. Yield unknown gpm Well water was ft. after hours pumping gpm  
 Bore Hole Diameter: 24 in. to ft. and in. to ft.  
 WELL WATER TO BE USED AS: 5 Public water supply 8 Air conditioning 11 Injection well  
 1 Domestic 3 Feedlot 6 Oil field water supply 9 Dewatering 12 Other (Specify below)  
 2 Irrigation 4 Industrial 7 Lawn and garden only 10 Monitoring well  
 Was a chemical/bacteriological sample submitted to Department? Yes No X; If yes, mo/day/yr sample was submitted Water Well Disinfected? Yes No X

5 TYPE OF BLANK CASING USED: 5 Wrought iron 8 Concrete tile CASING JOINTS: Glued Clamped  
 1 Steel 3 RMP (SR) 6 Asbestos-Cement 9 Other (specify below) Welded X  
 2 PVC 4 ABS 7 Fiberglass Threaded

Blank casing diameter: 16 in. to 48 ft., Dia. in. to ft., Dia. in. to ft.  
 Casing height above land surface: 12 in., weight 42.05 lbs./ft. Wall thickness or gauge No. 250

TYPE OF SCREEN OR PERFORATION MATERIAL: 7 PVC 10 Asbestos-cement  
 1 Steel 3 Stainless steel 5 Fiberglass 8 RMP (SR) 11 Other (specify)  
 2 Brass 4 Galvanized steel 6 Concrete tile 9 ABS 12 None used (open hole)

SCREEN OR PERFORATION OPENINGS ARE: 5 Gauzed wrapped 8 Saw cut 11 None (open hole)  
 1 Continuous slot 3 Mill slot 6 Wire wrapped 9 Drilled holes  
 2 Louvered shutter 4 Key punched 7 Torch cut 10 Other (specify) Bridge Slot

SCREEN-PERFORATED INTERVALS: From 48 ft. to 88 ft. From ft. to ft.  
 GRAVEL PACK INTERVALS: From 20 ft. to 88 ft. From ft. to ft.

6 GROUT MATERIAL: 1 Neat cement 2 Cement grout 3 Bentonite 4 Other  
 Grout Intervals: From 0 ft. to 20 ft. From ft. to ft. From ft. to ft.

What is the nearest source of possible contamination:  
 1 Septic tank 4 Lateral lines 7 Pit privy 10 Livestock pens 14 Abandoned water well  
 2 Sewer lines 5 Cess pool 8 Sewage lagoon 11 Fuel storage 15 Oil well/Gas well  
 3 Watertight sewer lines 6 Seepage pit 9 Feedyard 12 Fertilizer storage 16 Other (specify below)  
 13 Insecticide storage None known

Direction from well? How many feet?

FROM	TO	LITHOLOGIC LOG	FROM	TO	PLUGGING INTERVALS
0	4	Topsoil, sandy			
4	14	Clay, brown, sandy			
14	17	Sand, very fine to fine			
17	35	Clay, brown, sandy			
35	72	Sand and Gravel, fine to medium			
72	81	Sand and Gravel, medium to coarse			
81	83	Clay, tan, soft			
83	88	Sand and Gravel, fine, some medium			
88		Clay, tan			

7 CONTRACTOR'S OR LANDOWNER'S CERTIFICATION: This water well was (1) constructed, (2) reconstructed, or (3) plugged under my jurisdiction and was completed on (mo/day/year) 4-18-90 and this record is true to the best of my knowledge and belief. Kansas Water Well Contractor's License No. 185 This Water Well Record was completed on (mo/day/yr) 5-2-90 under the business name of Clarke Well & Equipment, Inc. by (signature)

INSTRUCTIONS: Use typewriter or ball point pen. PLEASE PRESS FIRMLY and PRINT clearly. Please fill in blanks, underline or circle the correct answers. Send top three copies to Kansas Department of Health and Environment, Bureau of Water, Topeka, Kansas 66620-7320. Telephone: 913-296-5545. Send one to WATER WELL OWNER and retain one for your records.

OFFICE USE ONLY  
T  
R  
EW  
SEC.