USE TYPEWRITER OR BALL POINT PEN-PRESS FIRMLY, PRINT CLEARLY.

WATER WELL RECORD
KSA 82a-1201-1215

Kansas Department of Health and Environment-Division of Environment
(Water well Contractors)
Topeka, Kansas 66620

1. Location of well:	County: Edwards	Fraction: SE 1/4 SW 1/4 SW 1/4	Section number: 18	Township number: T 24 S	Range number: R 16 E/W

2. Distance and direction from nearest town or city: 1 Mile South & West Belpre
Street address of well location if in city:

3. Owner of well: Sterling drilling co.
R.R. or street:
City, state, zip code: Sterling Tex

4. Locate with "X" in section below:

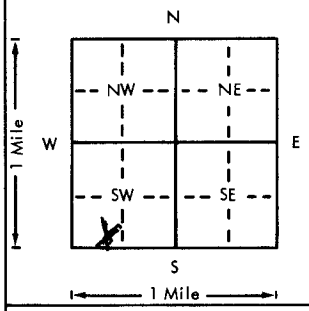

Sketch map:

6. Bore hole dia. 5 in. Completion date 9-25-06
Well depth 60 ft.

7. __ Cable tool X Rotary __ Driven __ Dug
__ Hollow rod __ Jetted __ Bored __ Reverse rotary

8. Use: __ Domestic __ Public supply __ Industry
__ Irrigation __ Air conditioning __ Stock
__ Lawn X Oil field water __ Other

9. Casing: Material Steel
Threaded __ Welded X
RMP __ PVC ✓
Dia. 5 in. to 60 ft. depth
Dia. __ in. to __ ft. depth
Height: Above or below
Surface 12 in.
Weight 28.73 lbs./ft.
Wall Thickness: inches or gage No. 200

10. Screen: Manufacturer's name Shop Made
Type Sand X Dia. 5
Slot/gauze Slot Length 30
Set between 40 ft. and 60 ft.
__ ft. and __ ft.
Gravel pack? X Size range of material 1/8-1/4

11. Static water level:
18 ft. below land surface Date 9-30-06 mo./day/yr.

12. Pumping level below land surfaces:
30 ft. after 1 hrs. pumping 80 g.p.m.
__ ft. after __ hrs. pumping __ g.p.m.
Estimated maximum yield 150 g.p.m.

13. Water sample submitted: mo./day/yr.
__ Yes X No Date

14. Well head completion:
__ Pitless adapter 12 inches above grade

15. Well grouted? X
With: __ Neat cement X Bentonite __ Concrete
Depth: From 0 ft. to 30 ft.

16. Nearest source of possible contamination:
ft. __ Direction __ Type
Well disinfected upon completion? __ Yes __ No

17. Pump: X Not installed
Manufacturer's name
Model number HP Volts
Length of drop pipe ft. capacity g.p.m.
Type:
__ Submersible __ Turbine
__ Jet __ Reciprocating
__ Centrifugal __ Other

5. Type and color of material

	From	To
Clay	0	20
Sandy Clay	20	40
Sand	40	60

(Use a second sheet if needed)

18. Elevation:

Topography:
__ Hill
X Slope
__ Upland
__ Valley

19. Remarks:

20. Water well contractor's certification:
This well was drilled under my jurisdiction and this report is true to the best of my knowledge and belief.
Myers Water Well Service
Business name License No.
Address Ark Bend Ks 64
Signed Authorized representative Date 9-21-

T 24 R 16 (W) m Sec 18 1/4 SE 1/4 SW 1/4

Forward the white, blue and pink copies to the Department of Health and Environment

Form WWC-5

MI-1023