


1 LOCATION OF WATER WELL: County: **Lawards** Fraction: **NE 1/4 SE 1/4 NW 1/4** Section Number: **25** Township Number: **T 24 S** Range Number: **R 16 EW**

Distance and direction from nearest town or city street address of well if located within city?
3 1/2 E 1/2 S. Belle Kansas

2 WATER WELL OWNER: **AI Sewing**
 RR#, St. Address, Box #: **Macksville Kansas**
 City, State, ZIP Code: **Macksville Kansas**
 Board of Agriculture, Division of Water Resources
 Application Number:

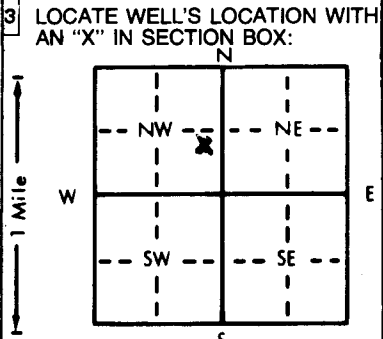

4 DEPTH OF COMPLETED WELL: **7.5** ft. ELEVATION: **812.82**
 WELL'S STATIC WATER LEVEL: **3.6** ft. below land surface measured on mo/day/yr **8-12-82**
 WELL WATER TO BE USED AS:
 Domestic 3 Feedlot 6 Oil field water supply 9 Dewatering 12 Other (Specify below)
 2 Irrigation 4 Industrial 7 Lawn and garden only 10 Observation well
 Was a chemical/bacteriological sample submitted to Department? Yes.....No..... If yes, mo/day/yr sample was submitted
 Water Well Disinfected? Yes No

5 TYPE OF BLANK CASING USED:
 1 Steel 2 PVC 3 RMP (SR) 4 ABS 5 Wrought iron 6 Asbestos-Cement 7 Fiberglass 8 Concrete tile 9 Other (specify below) 10 Asbestos-cement 11 Injection well 12 Other (Specify below)

CASING JOINTS: Glued Clamped Welded Threaded


TYPE OF SCREEN OR PERFORATION MATERIAL:
 1 Steel 2 Brass 3 Stainless steel 4 Galvanized steel 5 Fiberglass 6 Concrete tile 7 PVC 8 RMP (SR) 9 ABS 10 Asbestos-cement 11 Other (specify) 12 None used (open hole)

SCREEN OR PERFORATION OPENINGS ARE:
 1 Continuous slot 2 Louvered shutter 3 Mill slot 4 Key punched 5 Gauzed wrapped 6 Wire wrapped 7 Torch cut 8 Saw cut 9 Drilled holes 10 Other (specify) 11 None (open hole)




What is the nearest source of possible contamination:
 1 Septic tank 2 Sewer lines 3 Watertight sewer lines 4 Lateral lines 5 Cess pool 6 Seepage pit 7 Pit privy 8 Sewage lagoon 9 Feedyard 10 Livestock pens 11 Fuel storage 12 Fertilizer storage 13 Insecticide storage 14 Abandoned water well 15 Oil well/Gas well 16 Other (specify below) **Pasture**

Direction from well? **Cattle** How many feet?

FROM	TO	LITHOLOGIC LOG	FROM	TO	LITHOLOGIC LOG
0	2	Top Soil			
2	22	Tan Clay			
22	34	Gray Clay, Sand, Gyp			
34	43	Gray Sandy Clay			
43	51	Sand			
51	66	Gravel			
66	75	Tan Sandy Clay			

7 CONTRACTOR'S OR LANDOWNER'S CERTIFICATION: This water well was constructed, reconstructed, or plugged under my jurisdiction and was completed on (mo/day/year) **8-12-82** and this record is true to the best of my knowledge and belief. Kansas Water Well Contractor's License No. **24** This Water Well Record was completed on (mo/day/yr) **7-10-83** under the business name of **Carl Hays Water Well Serv.** by (signature) **Carl Hays**

INSTRUCTIONS: Use typewriter or ball point pen. PLEASE PRESS FIRMLY and PRINT clearly. Please fill in blanks, underline or circle the correct answers. Send top three copies to Kansas Department of Health and Environment, Division of Environment, Environmental Geology Section, Topeka, KS 66620. Send one to WATER WELL OWNER and retain one for your records.

OFFICE USE ONLY
T 24
R 16
EW
SEC 25
NE 1/4 SE 1/4 NW 1/4