


1 LOCATION OF WATER WELL: Fraction Section Number Township Number Range Number
 County: Edwards n 1/2 1/4 ~~SE~~ S 1/2 1/4 NE 1/4 29 T 24 S R 16 EW

Distance and direction from nearest town or city street address of well if located within city?
 3/4 south of Belpre, Ks.

2 WATER WELL OWNER: Garman Breitenbach Board of Agriculture, Division of Water Resources
 RR#, St. Address, Box #: Rt. 1 Application Number: 38,903
 City, State, ZIP Code: Belpre, Ks. 67519

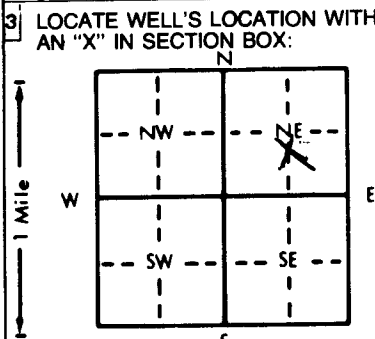

4 DEPTH OF COMPLETED WELL: 98 ft. ELEVATION: ft.
 Depth(s) Groundwater Encountered 1. ft. 2. ft. 3. ft.
 WELL'S STATIC WATER LEVEL .. 30 ft. below land surface measured on mo/day/yr .. 11-27-91
 Pump test data: Well water was .. 53 ft. after 1 hours pumping .. 800 gpm
 Est. Yield .. 1200. gpm: Well water was .. 59 ft. after 2 hours pumping .. 1000 gpm
 Bore Hole Diameter. in. to ft., and in. to ft.
 WELL WATER TO BE USED AS: 5 Public water supply 8 Air conditioning 11 Injection well
 1 Domestic 3 Feedlot 6 Oil field water supply 9 Dewatering 12 Other (Specify below)
 2 Irrigation 4 Industrial 7 Lawn and garden only 10 Monitoring well
 Was a chemical/bacteriological sample submitted to Department? Yes.....No.....x.....; If yes, mo/day/yr sample was submitted
 Water Well Disinfected? Yes hth No

5 TYPE OF BLANK CASING USED: 5 Wrought iron 8 Concrete tile CASING JOINTS: Glued .x. Clamped
 1 Steel 3 RMP (SR) 6 Asbestos-Cement 9 Other (specify below) Welded
 2 PVC 4 ABS 7 Fiberglass Threaded
 Blank casing diameter 16 in. to 58 ft., Dia in. to ft., Dia in. to ft.
 Casing height above land surface 12 in., weight SDR32.5 lbs./ft. Wall thickness or gauge No.
 TYPE OF SCREEN OR PERFORATION MATERIAL: 7 PVC 10 Asbestos-cement
 1 Steel 3 Stainless steel 5 Fiberglass 8 RMP (SR) 11 Other (specify)
 2 Brass 4 Galvanized steel 6 Concrete tile 9 ABS 12 None used (open hole)
 SCREEN OR PERFORATION OPENINGS ARE: 5 Gauzed wrapped 8 Saw cut 11 None (open hole)
 1 Continuous slot 3 Mill slot 6 Wire wrapped 9 Drilled holes
 2 Louvered shutter 4 Key punched 7 Torch cut 10 Other (specify)
 SCREEN-PERFORATED INTERVALS: From 58 ft. to 98 ft., From ft. to ft.
 From ft. to ft., From ft. to ft.
 GRAVEL PACK INTERVALS: From 20 ft. to 98 ft., From ft. to ft.
 From ft. to ft., From ft. to ft.

6 GROUT MATERIAL: 1 Neat cement 2 Cement grout 3 Bentonite 4 Other
 Grout Intervals: From 0 ft. to 20 ft., From ft. to ft., From ft. to ft.
 What is the nearest source of possible contamination:
 1 Septic tank 4 Lateral lines 7 Pit privy 10 Livestock pens 14 Abandoned water well
 2 Sewer lines 5 Cess pool 8 Sewage lagoon 11 Fuel storage 15 Oil well/Gas well
 3 Watertight sewer lines 6 Seepage pit 9 Feedyard 12 Fertilizer storage 16 Other (specify below)
 13 Insecticide storage none
 Direction from well? How many feet?

FROM	TO	LITHOLOGIC LOG	FROM	TO	PLUGGING INTERVALS
0	3	Top soil			
3	28	Brown clay			
28	42	Sand and gravel fine to medium			
42	43	Clay orange			
43	54	Sand and gravel fine to medium			
54	57	tan and orange clay			
57	75	Sand and gravel medium coarse loose clean			
75	98	Sand and gravel loose and clean			
98	141	Brown clay			

7 CONTRACTOR'S OR LANDOWNER'S CERTIFICATION: This water well was (1) constructed, (2) reconstructed, or (3) plugged under my jurisdiction and was completed on (mo/day/year) 12-6-91 and this record is true to the best of my knowledge and belief. Kansas Water Well Contractor's License No. 1x 134. This Water Well Record was completed on (mo/day/yr) 2-12-93 under the business name of Rosencrantz-Bemis by (signature) *Judith Rodson*

INSTRUCTIONS: Use typewriter or ball point pen. PLEASE PRESS FIRMLY and PRINT clearly. Please fill in blanks, underline or circle the correct answers. Send top three copies to Kansas Department of Health and Environment, Bureau of Water, Topeka, Kansas 66620-0001. Telephone: 913-296-5545. Send one to WATER WELL OWNER and retain one for your records.

OFFICE USE ONLY
T
R
EW
SEC.