USE TYPEWRITER OR BALL POINT PEN-PRESS FIRMLY, PRINT CLEARLY.

WATER WELL RECORD
KSA 82a-1201-1215

Kansas Department of Health and Environment-Division of Environment
(Water well Contractors)
Topeka, Kansas 66620

1. Location of well:	County	Fraction	Section number	Township number	Range number
	Edwards	C 1/4 E 1/2 1/4 SE 1/4	33	T 24 S	R 16 W E/W

2. Distance and direction from nearest town or city: Belpre Hwy 50 1 EAST 2 3/4 SOUTH WESTSIDE
Street address of well location if in city:

3. Owner of well: Sterling Delg
R.R. or street:
City, state, zip code: Sterling Ks

4. Locate with "X" in section below:

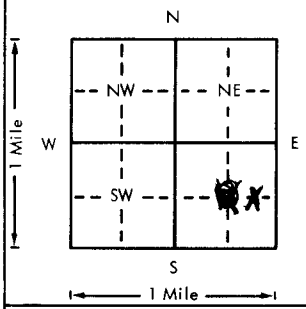

Sketch map:

6. Bore hole dia. 7 in. Completion date
Well depth 75 ft. 12-9-78

7. __ Cable tool X Rotary __ Driven __ Dug
__ Hollow rod __ Jetted __ Bored __ Reverse rotary

8. Use: __ Domestic __ Public supply __ Industry
__ Irrigation __ Air conditioning __ Stock
__ Lawn X Oil field water __ Other

9. Casing: Material
Threaded __ Welded X
RMP PVC X
Dia. 5 in. to 75 ft. depth
Dia. __ in. to __ ft. depth
Height: Above or below Surface 12 in.
Weight 278-3 lbs./ft.
Wall Thickness: inches or gage No. 200

5. Type and color of material	From	To
Sandy Clay	0	20
Clay	20	40
Sandy Clay	40	60
Gravel	60	75

(Use a second sheet if needed)

10. Screen: Manufacturer's name Peerless
Type Saw Dia. 5
Slot/gauze 78 Length 20
Set between 75 ft. and 55 ft.
ft. and ft.
Gravel pack? yes Size range of material 1/4-7/8

11. Static water level: mo./day/yr.
25 ft. below land surface Date

12. Pumping level below land surfaces:
ft. after hrs. pumping g.p.m.
ft. after hrs. pumping g.p.m.
Estimated maximum yield g.p.m.

13. Water sample submitted: mo./day/yr.
__ Yes X No Date

14. Well head completion:
__ Pitless adapter 12 Inches above grade

15. Well grouted? yes
With: __ Neat cement X Bentonite __ Concrete
Depth: From 0 ft. to 10 ft.

16. Nearest source of possible contamination:
ft. Direction Type
Well disinfected upon completion? __ Yes __ No

17. Pump: __ Not installed
Manufacturer's name
Model number HP Volts
Length of drop pipe ft. capacity g.p.m.
Type:
__ Submersible __ Turbine
__ Jet __ Reciprocating
__ Centrifugal __ Other

T 24 R 16 E/W Sec 33 CE 1/4 SE 1/4

18. Elevation:

Topography:
__ Hill
X Slope
__ Upland
__ Valley

19. Remarks:

20. Water well contractor's certification:
This well was drilled under my jurisdiction and this report is true to the best of my knowledge and belief.
Myers Well 143
Business name License No.
Address Great Bend Ks
Signed Leland Rosendall (Authorized representative) Date 12-9

Forward the white, blue and pink copies to the Department of Health and Environment

Form WWC-5

MI-1023