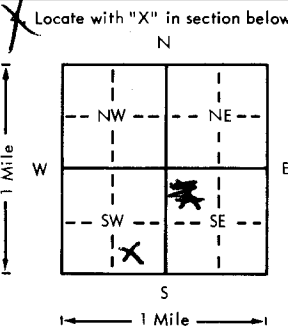


USE TYPEWRITER OR BALL POINT PEN-PRESS FIRMLY, PRINT CLEARLY.

WATER WELL RECORD
KSA 82a-1201-1215

16W RPS
6/10/81

Kansas Department of Health and Environment-Division of Environment
Water well Contractors)
Topeka, Kansas 66620

1. Location of well: County <u>Edwards</u> Fraction <u>C 1/4 SE 1/4 NW 1/4</u> Section number <u>35</u> Township number <u>T 24S</u> Range number <u>S 16W</u> E/W																
2. Distance and direction from nearest town or city: <u>Bulpee Ks</u> 2 1/2 miles south 1/2 mile west Street address of well location if in city: <u>25 1/2 E - 128.</u>																
3. Owner of well: <u>Noskey, Delg</u> R.R. or street: <u>800 Bittling Blg</u> City, state, zip code: <u>Wichita Ks.</u>																
<input checked="" type="checkbox"/> Locate with "X" in section below: Sketch map: <div style="display: flex; align-items: center;">  <div style="margin-left: 20px;"> <p>1 Mile</p> <p>1 Mile</p> </div> </div>																
4. Bore hole dia. <u>9</u> in. Completion date <u>9-15-78</u> Well depth <u>60</u> ft.																
7. <input checked="" type="checkbox"/> Cable tool <input checked="" type="checkbox"/> Rotary <input type="checkbox"/> Driven <input type="checkbox"/> Dug <input type="checkbox"/> Hollow rod <input type="checkbox"/> Jetted <input type="checkbox"/> Bored <input type="checkbox"/> Reverse rotary																
8. Use: <input type="checkbox"/> Domestic <input type="checkbox"/> Public supply <input type="checkbox"/> Industry <input type="checkbox"/> Irrigation <input type="checkbox"/> Air conditioning <input type="checkbox"/> Stock <input type="checkbox"/> Lawn <input checked="" type="checkbox"/> Oil field water <input type="checkbox"/> Other																
9. Casing: Material <input type="checkbox"/> Threaded <input type="checkbox"/> Welded <input checked="" type="checkbox"/> Surface <u>12</u> in. RMP <input type="checkbox"/> PVC <input checked="" type="checkbox"/> Weight <u>278-3</u> lbs./ft. Dia. <u>5</u> in. to <u>60</u> ft. depth Wall Thickness: inches or Dia. <input type="checkbox"/> in. to <input type="checkbox"/> ft. depth gage No. <u>200</u>																
5. Type and color of material <table border="1" style="width:100%; border-collapse: collapse;"> <thead> <tr> <th></th> <th>From</th> <th>To</th> </tr> </thead> <tbody> <tr> <td><u>Fine Sand</u></td> <td><u>0</u></td> <td><u>10</u></td> </tr> <tr> <td><u>Clay</u></td> <td><u>10</u></td> <td><u>30</u></td> </tr> <tr> <td><u>Fine Sand</u></td> <td><u>30</u></td> <td><u>40</u></td> </tr> <tr> <td><u>Gravel</u></td> <td><u>40</u></td> <td><u>60</u></td> </tr>
10. Screen: Manufacturer's name <u>Peebles Mfg</u> Type <u>Saw</u> Dia. <u>5</u> Slot/gauze <u>1/8</u> Length <u>20</u> Set between <u>60</u> ft. and <u>40</u> ft. <input type="checkbox"/> ft. and <input type="checkbox"/> ft. Gravel pack <u>yes</u> Size range of material <u>1/4-1/8</u>																
11. Static water level: <u>18</u> ft. below land surface Date <u>9-15-78</u> mo./day/yr.																
12. Pumping level below land surfaces: <input type="checkbox"/> ft. after <input type="checkbox"/> hrs. pumping <input type="checkbox"/> g.p.m. <input type="checkbox"/> ft. after <input type="checkbox"/> hrs. pumping <input type="checkbox"/> g.p.m. Estimated maximum yield <input type="checkbox"/> g.p.m.																
13. Water sample submitted: <input type="checkbox"/> Yes <input checked="" type="checkbox"/> No Date _____ mo./day/yr.																
14. Well head completion: <input type="checkbox"/> Pitless adapter <u>12</u> Inches above grade																
15. Well grouted? <u>yes</u> With: <input type="checkbox"/> Neat cement <input checked="" type="checkbox"/> Bentonite <input type="checkbox"/> Concrete Depth: From <u>0</u> ft. to <u>10</u> ft.																
16. Nearest source of possible contamination: ft. _____ Direction _____ Type _____ Well disinfected upon completion? <input type="checkbox"/> Yes <input type="checkbox"/> No																
<input checked="" type="checkbox"/> Pump: <input checked="" type="checkbox"/> Not installed Manufacturer's name _____ Model number _____ HP _____ Volts _____ Length of drop pipe _____ ft. capacity _____ g.p.m. Type: <input type="checkbox"/> Submersible <input type="checkbox"/> Turbine <input type="checkbox"/> Jet <input type="checkbox"/> Reciprocating <input type="checkbox"/> Centrifugal <input type="checkbox"/> Other																
(Use a second sheet if needed)																
18. Elevation:	19. Remarks:															
Topography: <input type="checkbox"/> Hill <input checked="" type="checkbox"/> Slope <input type="checkbox"/> Upland <input type="checkbox"/> Valley	20. Water well contractor's certification: This well was drilled under my jurisdiction and this report is true to the best of my knowledge and belief. <u>Mgers Water Well 143</u> Business name _____ License No. _____ Address <u>Great Bend Ks</u> Signed <u>Floyd Rosendall</u> Date <u>9-15-78</u> Authorized representative															

T
R
E
S
E
C
1/4 1/4 1/4 1/4
 94
150
35
CSE NW

Forward the white, blue and pink copies to the Department of Health and Environment

Form WWC-5