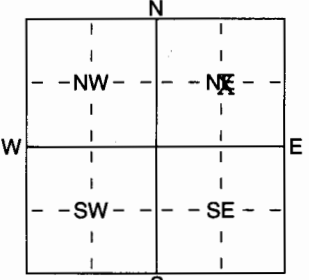


1 LOCATION OF WATER WELL: Fraction  $\frac{1}{4}$  NC ~~XX~~ NE  $\frac{1}{4}$  Section Number 28 Township Number T 24 S Range Number R 16 ~~X~~/W  
 County: Edwards

Distance and direction from nearest town or city street address of well if located within city?  
 $\frac{1}{2}$  South,  $\frac{3}{4}$  East of Belpre

2 WATER WELL OWNER: F G Holl  
 RR#, St. Address, Box # : 9431 E. Central #100  
 City, State, ZIP Code : Wichita, Ks. 67206-2543  
 EDWW3147  
 Board of Agriculture, Division of Water Resources  
 Application Number: 20050313

3 LOCATE WELL'S LOCATION WITH AN "X" IN SECTION BOX:  
  
 4 DEPTH OF COMPLETED WELL ..... 90 ..... ft. ELEVATION: .....  
 Depth(s) Groundwater Encountered 1 ..... ft. 2 ..... ft. 3 ..... ft.  
 WELL'S STATIC WATER LEVEL ..... 30 ..... ft. below land surface measured on mo/day/yr ..... 10-13-05  
 Pump test data: Well water was ..... ft. after ..... hours pumping ..... gpm  
 Est. Yield N/A ..... gpm: Well water was ..... ft. after ..... hours pumping ..... gpm  
 WELL WATER TO BE USED AS: 5 Public water supply 8 Air conditioning 11 Injection well  
 1 Domestic 3 Feedlot 6 Oil field water supply 9 Dewatering 12 Other (Specify below)  
 2 Irrigation 4 Industrial 7 Domestic (lawn & garden) 10 Monitoring well .....  
 Was a chemical/bacteriological sample submitted to Department? Yes ..... No X .....; If yes, mo/day/yr sample was submitted  
 Water Well Disinfected? Yes HTH No

5 TYPE OF BLANK CASING USED:  
 1 Steel 3 RMP (SR) 5 Wrought iron 8 Concrete tile CASING JOINTS: Glued ..... X ..... Clamped .....  
 2 PVC 4 ABS 6 Asbestos-Cement 9 Other (specify below) Welded .....  
 Blank casing diameter ..... 5 ..... in. to ..... 70 ..... ft., Dia ..... in. to ..... ft., Dia ..... in. to ..... ft.  
 Casing height above land surface ..... 36 ..... in., weight SDR-26 ..... lbs./ft. Wall thickness or guage No. ....  
 TYPE OF SCREEN OR PERFORATION MATERIAL:  
 1 Steel 3 Stainless Steel 5 Fiberglass 7 PVC 10 Asbestos-Cement  
 2 Brass 4 Galvanized Steel 6 Concrete tile 8 RMP (SR) 11 Other (Specify) .....  
 9 ABS 12 None used (open hole)  
 SCREEN OR PERFORATION OPENINGS ARE:  
 1 Continuous slot 3 Mill slot 5 Gauzed wrapped 8 Saw cut 11 None (open hole)  
 2 Louvered shutter 4 Key punched 6 Wire wrapped 9 Drilled holes  
 7 Torch cut 10 Other (specify) ..... ft.  
 SCREEN-PERFORATED INTERVALS: From ..... 90 ..... ft. to ..... 70 ..... ft., From ..... ft. to ..... ft.  
 From ..... ft. to ..... ft., From ..... ft. to ..... ft.  
 GRAVEL PACK INTERVALS: From ..... 90 ..... ft. to ..... 20 ..... ft., From ..... ft. to ..... ft.  
 From ..... ft. to ..... ft., From ..... ft. to ..... ft.

6 GROUT MATERIAL: 1 Neat cement 2 Cement grout 3 Bentonite 4 Other hole plug  
 Grout Intervals: From ..... 20 ..... ft. to ..... 0 ..... ft., From ..... ft. to ..... ft., From ..... ft. to ..... ft.  
 What is the nearest source of possible contamination:  
 1 Septic tank 4 Lateral lines 7 Pit privy 10 Livestock pens 14 Abandoned water well  
 2 Sewer lines 5 Cess pool 8 Sewage lagoon 11 Fuel storage 15 Oil well/Gas well  
 3 Watertight sewer lines 6 Seepage pit 9 Feedyard 12 Fertilizer storage 16 Other (specify below)  
 13 Insecticide storage ..... None .....  
 Direction from well? How many feet?

FROM	TO	LITHOLOGIC LOG	FROM	TO	PLUGGING INTERVALS
0	12	Clay			
12	20	Sandy clay			
20	36	Sand, gravel, & clay mixed			
36	50	Sandy clay			
50	90	Sand & gravel			

7 CONTRACTOR'S OR LANDOWNER'S CERTIFICATION: This water well was (1) constructed, (2) reconstructed, or (3) plugged under my jurisdiction and was completed on (mo/day/year) ..... 10-13-05 ..... and this record is true to the best of my knowledge and belief. Kansas Water Well Contractor's Licence No ..... 134 ..... This Water Well Record was completed on (mo/day/yr) ..... 10-17-05 ..... under the business name of Rosencrantz- Bemis by (signature) John Albe