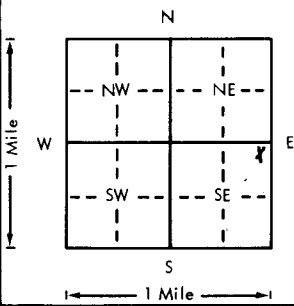


USE TYPEWRITER OR BALL POINT PEN-PRESS FIRMLY, PRINT CLEARLY.

WATER WELL RECORD  
KSA 82a-1201-1215

Kansas Department of Health and Environment-Division of Environment  
(Water well Contractors)  
Topeka, Kansas 66620

1. Location of well: County <u>EDWARDS</u> Fraction <u>NE 1/4 NE 1/4 SE 1/4</u> Section number <u>1</u> Township number <u>T 24 S</u> Range number <u>R 17 W</u> E/W	
2. Distance and direction from nearest town or city: <u>Belpre</u> Street address of well location if in city: <u>3 North - 2 West - 3 South</u>	
3. Owner of well: <u>Stirling Shelling Co.</u> R.R. or street: <u>Box 129</u> City, state, zip code: <u>Stirling Kansas 67579</u>	
4. Locate with "X" in section below: 	6. Bore hole dia. <u>9</u> in. Completion date <u>4-16-79</u> Well depth <u>60</u> ft.
	7. <input type="checkbox"/> Cable tool <input checked="" type="checkbox"/> Rotary <input type="checkbox"/> Driven <input type="checkbox"/> Dug <input type="checkbox"/> Hollow rod <input type="checkbox"/> Jetted <input type="checkbox"/> Bored <input type="checkbox"/> Reverse rotary
8. Use: <input type="checkbox"/> Domestic <input type="checkbox"/> Public supply <input type="checkbox"/> Industry <input type="checkbox"/> Irrigation <input type="checkbox"/> Air conditioning <input type="checkbox"/> Stock <input type="checkbox"/> Lawn <input checked="" type="checkbox"/> Oil field water <input type="checkbox"/> Other	
9. Casing: Material <input type="checkbox"/> Height: <u>Above or below</u> Threaded <input type="checkbox"/> Welded <input type="checkbox"/> Surface <u>12' above</u> RMP <input type="checkbox"/> PVC <input checked="" type="checkbox"/> Weight <u>278.3</u> lb./ft. Dia. <u>5</u> in. to <u>60</u> ft. depth Wall Thickness: inches or Dia. <input type="checkbox"/> in. to <input type="checkbox"/> ft. depth gage No. <u>205</u>	
5. Type and color of material	10. Screen: Manufacturer's name <u>Jet Sherm</u> Type <u>Saw</u> Dia. <u>5</u> Slot/gauze <u>1/8</u> Length <u>20</u> Set between <u>8</u> ft. and <u>60</u> ft. ft. and <input type="checkbox"/> ft. Gravel pack? <input checked="" type="checkbox"/> Size range of material <u>1/4 - 1/2</u>
	11. Static water level: <u>22</u> ft. below land surface Date <u>4-16-79</u> mo./day/yr.
	12. Pumping level below land surfaces: ____ ft. after ____ hrs. pumping ____ g.p.m. ____ ft. after ____ hrs. pumping ____ g.p.m. Estimated maximum yield ____ g.p.m.
	13. Water sample submitted: ____ mo./day/yr. <input type="checkbox"/> Yes <input checked="" type="checkbox"/> No Date ____
	14. Well head completion: <input type="checkbox"/> Pitless adapter <u>12</u> Inches above grade
	15. Well grouted? <input checked="" type="checkbox"/> With: <input type="checkbox"/> Neat cement <input checked="" type="checkbox"/> Bentonite <input type="checkbox"/> Concrete Depth: From <u>0</u> ft. to <u>12</u> ft.
	16. Nearest source of possible contamination: ft. ____ Direction ____ Type <u>road</u> Well disinfected upon completion? <input type="checkbox"/> Yes <input checked="" type="checkbox"/> No
	17. Pump: <input checked="" type="checkbox"/> Not installed Manufacturer's name ____ Model number ____ HP ____ Volts ____ Length of drop pipe ____ ft. capacity ____ g.p.m. Type: <input type="checkbox"/> Submersible <input type="checkbox"/> Turbine <input type="checkbox"/> Jet <input type="checkbox"/> Reciprocating <input type="checkbox"/> Centrifugal <input type="checkbox"/> Other
(Use a second sheet if needed)	
18. Elevation:  Topography: <input type="checkbox"/> Hill <input checked="" type="checkbox"/> Slope <input type="checkbox"/> Upland <input type="checkbox"/> Valley	19. Remarks:  20. Water well contractor's certification: This well was drilled under my jurisdiction and this report is true to the best of my knowledge and belief. <u>Myers Water Well Service</u> License No. <u>1403</u> Address <u>Just West</u> Signed <u>4-16-79</u> Date <u>4-16-79</u> Authorized Representative

T 24 S  
 R 17 W  
 Sec 1  
 NE 1/4 NE 1/4 SE 1/4

Forward the white, blue and pink copies to the Department of Health and Environment

Form WWC-5