


HAMMEKE 4-3

1 LOCATION OF WATER WELL: Fraction SE 1/4 SW 1/4 SW 1/4 Section Number 3 Township Number T 24 S Range Number R 17 EW

Distance and direction from nearest town or city street address of well if located within city? BELPRE 3 1/2 W 2 N 3 1/4 W NORTH SIDE

2 WATER WELL OWNER: STERLING DRILLING CO. VERNON HAMMEKE, P. ELLINWOOD, KS. Board of Agriculture, Division of Water Resources Application Number: T85-58

3 LOCATE WELL'S LOCATION WITH AN "X" IN SECTION BOX: 4 DEPTH OF COMPLETED WELL: 65 ft. ELEVATION: 65

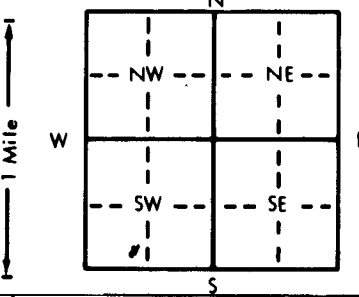

Depth(s) Groundwater Encountered 1. 28 ft. 2. 35 ft. 3. ft. WELL'S STATIC WATER LEVEL 25 ft. below land surface measured on mo/day/yr 1-8-85

5 TYPE OF BLANK CASING USED: 1 Steel 3 RMP (SR) 5 Wrought iron 8 Concrete tile CASING JOINTS: Glued X Clamped

Blank casing diameter 5 in. to 45 ft. Dia. Casing height above land surface 12 in., weight 2.65 lbs./ft. Wall thickness or gauge No. 214

TYPE OF SCREEN OR PERFORATION MATERIAL: 1 Steel 3 Stainless steel 5 Fiberglass 8 RMP (SR) 10 Asbestos-cement

SCREEN OR PERFORATION OPENINGS ARE: 1/8 1 Continuous slot 3 Mill slot 5 Gauzed wrapped 8 Saw cut 11 None (open hole)

SCREEN-PERFORATED INTERVALS: From 45 ft. to 65 ft. GRAVEL PACK INTERVALS: From 35 ft. to 65 ft.

6 GROUT MATERIAL: 1 Neat cement 2 Cement grout 3 Bentonite 4 Other Grout Intervals: From 0 ft. to 10 ft.

What is the nearest source of possible contamination: NONE 10 Livestock pens 14 Abandoned water well 11 Fuel storage 15 Oil well/Gas well

Direction from well? How many feet?

Table with columns FROM, TO, LITHOLOGIC LOG. Entries include TOP SOIL, 20" CLAY, 30" GRAVEL, 35" CLAY, 65" GRAVEL.

7 CONTRACTOR'S OR LANDOWNER'S CERTIFICATION: This water well was (1) constructed, (2) reconstructed, or (3) plugged under my jurisdiction and was completed on (mo/day/year) 1-8-85

INSTRUCTIONS: Use typewriter or ball point pen, PLEASE PRESS FIRMLY and PRINT clearly. Please fill in blanks, underline or circle the correct answers.

OFFICE USE ONLY T 24 R 17 SEC. 3

SE 1/4 SW 1/4 SW 1/4

Handwritten initials or mark at the bottom of the page.