


1 LOCATION OF WATER WELL: County: <u>Edwards</u>	Fraction <u>C 1/4 NW 1/4 SW 1/4</u>	Section Number <u>4</u>	Township Number <u>T 24 S</u>	Range Number <u>R 17W E/W</u>
---	--	----------------------------	----------------------------------	----------------------------------

Distance and direction from nearest town or city street address of well if located within city?
2 E, 3 N of Lewis, Kansas

2 WATER WELL OWNER: <u>Earl Aldrich</u>	<u>Sterling Drilling</u>	<u>Aldrich 2-4</u>
RR#, St. Address, Box # : <u>Alema, Kansas</u>	<u>Box 129</u>	<u>Board of Agriculture, Division of Water Resources</u>
City, State, ZIP Code : <u>67622</u>	<u>Sterling, Kansas 67579</u>	Application Number: <u>T88-117</u>

3 LOCATE WELL'S LOCATION WITH AN "X" IN SECTION BOX:

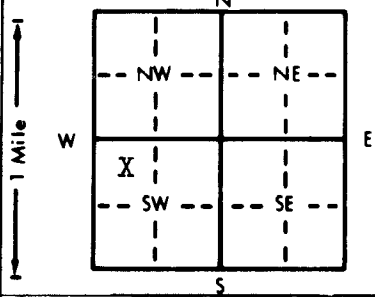

4 DEPTH OF COMPLETED WELL: <u>65</u> ft.	ELEVATION: <u>Unk. own</u>				
Depth(s) Groundwater Encountered <u>1.25</u> ft.	ft. 2. ft. 3. ft.				
WELL'S STATIC WATER LEVEL: <u>25</u> ft. below land surface	measured on <u>mo/day/yr</u> <u>2/29/88</u>				
Pump test data: Well water was	ft. after				
Est. Yield <u>60</u> gpm: Well water was	ft. after				
Bore Hole Diameter: <u>8</u> in. to <u>65</u> ft., and	in. to				
WELL WATER TO BE USED AS:					
1 Domestic	3 Feedlot	6 <u>Oil field water supply</u>	9 Dewatering	11 Injection well	12 Other (Specify below)
2 Irrigation	4 Industrial	7 Lawn and garden only	10 Observation well		
Was a chemical/bacteriological sample submitted to Department? Yes..... <u>No</u>; If yes, mo/day/yr sample was submitted					
Water Well Disinfected? Yes..... <u>No</u>					

5 TYPE OF BLANK CASING USED:	5 Wrought iron	8 Concrete tile	CASING JOINTS: <u>Glued</u>	Clamped
1 Steel	3 RMP (SR)	6 Asbestos-Cement	9 Other (specify below)	Welded
<u>2 PVC</u>	4 ABS	7 Fiberglass		Threaded
Blank casing diameter: <u>5</u> in. to <u>45</u> ft., Dia	in. to	ft., Dia	in. to	ft.
Casing height above land surface: <u>12</u> in., weight <u>2.8</u> lbs./ft.	Wall thickness or gauge No. <u>Sch. 40</u>			
TYPE OF SCREEN OR PERFORATION MATERIAL:		7 <u>PVC</u>	10 Asbestos-cement	
1 Steel	3 Stainless steel	5 Fiberglass	8 RMP (SR)	11 Other (specify)
2 Brass	4 Galvanized steel	6 Concrete tile	9 ABS	12 None used (open hole)
SCREEN OR PERFORATION OPENINGS ARE:	5 Gauzed wrapped	8 <u>Saw cut</u>	11 None (open hole)	
1 Continuous slot	3 Mill slot	6 Wire wrapped	9 Drilled holes	
2 Louvered shutter	4 Key punched	7 Torch cut	10 Other (specify)	
SCREEN-PERFORATED INTERVALS: From <u>45</u> ft. to <u>65</u> ft.	ft. to	ft. to	ft. to	ft.
GRAVEL PACK INTERVALS: From <u>20</u> ft. to <u>65</u> ft.	ft. to	ft. to	ft. to	ft.

6 GROUT MATERIAL: <u>1 Neat cement</u>	2 Cement grout	3 Bentonite	4 Other	
Grout Intervals: From <u>0</u> ft. to <u>20</u> ft.	ft. to	ft. to	ft. to	
What is the nearest source of possible contamination:		10 Livestock pens	14 Abandoned water well	
1 Septic tank	4 Lateral lines	7 Pit privy	11 Fuel storage	15 <u>Oil well/Gas well</u>
2 Sewer lines	5 Cess pool	8 Sewage lagoon	12 Fertilizer storage	16 Other (specify below)
3 Watertight sewer lines	6 Seepage pit	9 Feedyard	13 Insecticide storage	
Direction from well? <u>South</u>		How many feet? <u>60</u>		

FROM	TO	LITHOLOGIC LOG	FROM	TO	LITHOLOGIC LOG
0	20	Clay			
20	65	Sand and Gravel			

7 CONTRACTOR'S OR LANDOWNER'S CERTIFICATION: This water well was (1) constructed, (2) reconstructed, or (3) plugged under my jurisdiction and was completed on (mo/day/year) 2/29/88 and this record is true to the best of my knowledge and belief. Kansas Water Well Contractor's License No. 186 This Water Well Record was completed on (mo/day/yr) 4/6/88 under the business name of Kelly's Water Well Service by (signature) [Signature]

INSTRUCTIONS: Use typewriter or ball point pen. PLEASE PRESS FIRMLY and PRINT clearly. Please fill in blanks, underline or circle the correct answers. Send top three copies to Kansas Department of Health and Environment, Bureau of Water Protection, Topeka, Kansas 66620-7320, Telephone: 913-862-9360. Send one to WATER WELL OWNER and retain one for your records.

OFFICE USE ONLY
T
R
EW
SEC.
1/4
1/4
1/4