


1 LOCATION OF WATER WELL: County: <u>Edwards</u>	Fraction <u>SW 1/4 NW 1/4 SW 1/4</u>	Section Number <u>5</u>	Township Number <u>T 24 S</u>	Range Number <u>R 17W E/W</u>
---	---	----------------------------	----------------------------------	----------------------------------

Distance and direction from nearest town or city street address of well if located within city?  
1 E, 4 N of Lewis, Kansas

2 WATER WELL OWNER: <u>Dolores Dean</u>	<u>Sterling Drilling Co.</u>	<u>Dolores 1-5</u>
RR#, St. Address, Box # : <u>Corpus Christi, Tx. Box 129</u>	<u>Sterling, Kansas 67579</u>	Board of Agriculture, Division of Water Resources
City, State, ZIP Code : <u>Sterling, Kansas 67579</u>		Application Number: <u>910246</u>

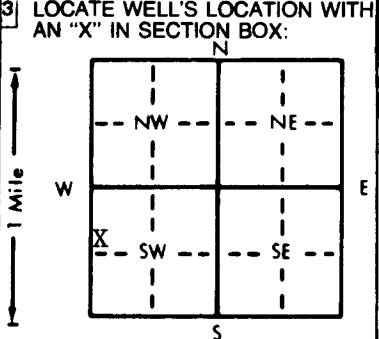

4 DEPTH OF COMPLETED WELL: <u>70</u> ft.	ELEVATION: <u>Unknown</u>
Depth(s) Groundwater Encountered 1. <u>27</u> ft. 2. _____ ft. 3. _____ ft.	
WELL'S STATIC WATER LEVEL: <u>27</u> ft. below land surface measured on <u>mo/day/yr</u> <u>5/30/91</u>	
Pump test data: Well water was _____ ft. after _____ hours pumping _____ gpm	
Est. Yield: <u>60</u> gpm: Well water was _____ ft. after _____ hours pumping _____ gpm	
Bore Hole Diameter: <u>8</u> in. to <u>70</u> ft., and _____ in. to _____ ft.	
WELL WATER TO BE USED AS:	
5 Public water supply	8 Air conditioning
11 Injection well	
1 Domestic	3 Feedlot
6 Oil field water supply	9 Dewatering
12 Other (Specify below)	
2 Irrigation	4 Industrial
7 Lawn and garden only	10 Monitoring well
Was a chemical/bacteriological sample submitted to Department? Yes _____ No _____	If yes, mo/day/yr sample was submitted _____
Water Well Disinfected? Yes _____ No _____	

5 TYPE OF BLANK CASING USED:	5 Wrought iron	8 Concrete tile	CASING JOINTS: <u>Glued</u> _____ Clamped _____
1 Steel	3 RMP (SR)	6 Asbestos-Cement	9 Other (specify below) _____
2 PVC	4 ABS	7 Fiberglass	_____ Welded _____
Blank casing diameter: <u>5</u> in. to <u>50</u> ft., Dia _____ in. to _____ ft., Dia _____ in. to _____ ft.			_____ Threaded _____
Casing height above land surface: <u>12</u> in., weight <u>2,8</u> lbs./ft. Wall thickness or gauge No. <u>Sch. 40</u>			
TYPE OF SCREEN OR PERFORATION MATERIAL:	<u>7 PVC</u>	10 Asbestos-cement	
1 Steel	3 Stainless steel	5 Fiberglass	8 RMP (SR)
2 Brass	4 Galvanized steel	6 Concrete tile	9 ABS
11 Other (specify) _____			12 None used (open hole)
SCREEN OR PERFORATION OPENINGS ARE:	5 Gauzed wrapped	8 Saw cut	11 None (open hole)
1 Continuous slot	3 Mill slot	6 Wire wrapped	9 Drilled holes
2 Louvered shutter	4 Key punched	7 Torch cut	10 Other (specify) _____
SCREEN-PERFORATED INTERVALS: From _____ 50 ft. to _____ 70 ft., From _____ ft. to _____ ft.			
GRAVEL PACK INTERVALS: From _____ 20 ft. to _____ 70 ft., From _____ ft. to _____ ft.			

6 GROUT MATERIAL:	1 Neat cement	2 Cement grout	3 Bentonite	4 Other _____
Grout intervals: From <u>0</u> ft. to <u>20</u> ft., From _____ ft. to _____ ft., From _____ ft. to _____ ft.				
What is the nearest source of possible contamination:	1 Septic tank	4 Lateral lines	7 Pit privy	10 Livestock pens
	2 Sewer lines	5 Cess pool	8 Sewage lagoon	11 Fuel storage
	3 Watertight sewer lines	6 Seepage pit	9 Feedyard	12 Fertilizer storage
				13 Insecticide storage
Direction from well? <u>South</u>				14 Abandoned water well
				15 Oil well/Gas well
				16 Other (specify below) _____

FROM	TO	LITHOLOGIC LOG	FROM	TO	PLUGGING INTERVALS
0	20	Clay			
20	70	Sand and gravel			

7 CONTRACTOR'S OR LANDOWNER'S CERTIFICATION: This water well was (1) constructed, (2) reconstructed, or (3) plugged under my jurisdiction and was completed on (mo/day/year) 5/30/91 and this record is true to the best of my knowledge and belief. Kansas Water Well Contractor's License No. 186 This Water Well Record was completed on (mo/day/yr) 6/23/91 under the business name of Kelly's Water Well Service by (signature) Douglas Dean

INSTRUCTIONS: Use typewriter or ball point pen. PLEASE PRESS FIRMLY and PRINT clearly. Please fill in blanks, underline or circle the correct answers. Send top three copies to Kansas Department of Health and Environment, Bureau of Water, Topeka, Kansas 66620-7320. Telephone: 913-296-5545. Send one to WATER WELL OWNER and retain one for your records.

OFFICE USE ONLY  
T  
R  
EW  
SEC.  
1/4  
1/4  
1/4