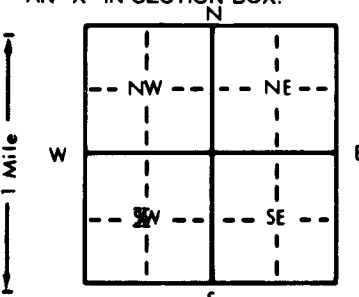


1 LOCATION OF WATER WELL: County: <u>Edwards</u>	Fraction <u>C</u> $\frac{1}{4}$ <u>SW</u> $\frac{1}{4}$ $\frac{1}{4}$	Section Number <u>13</u>	Township Number <u>T</u> <u>24</u> <u>S</u>	Range Number <u>R</u> <u>17W</u> <u>E/W</u>
---	--	-----------------------------	--	--

Distance and direction from nearest town or city street address of well if located within city?  
3 W,  $\frac{1}{2}$  N of Belpre, Kansas


2 WATER WELL OWNER: <u>Art Miller</u> RR#, St. Address, Box #: <u>Larned, Kansas</u> City, State, ZIP Code: <u>67550</u>	<u>Sterling Drilling</u> Box 129 <u>Sterling, Kansas 67579</u>	<u>Miller 4-B 4-13</u> Board of Agriculture, Division of Water Resources Application Number: <u>T87-111</u>
--	--	---

3 LOCATE WELL'S LOCATION WITH AN "X" IN SECTION BOX: 	4 DEPTH OF COMPLETED WELL: <u>74</u> ft. ELEVATION: _____
	Depth(s) Groundwater Encountered 1. _____ ft. 2. _____ ft. 3. _____ ft. WELL'S STATIC WATER LEVEL: <u>25</u> ft. below land surface measured on <u>mo/day/yr</u> <u>9/25/87</u> Pump test data: Well water was _____ ft. after _____ hours pumping _____ gpm Est. Yield _____ gpm: Well water was _____ ft. after _____ hours pumping _____ gpm Bore Hole Diameter: _____ in. to _____ ft., and _____ in. to _____ ft. WELL WATER TO BE USED AS: 1 Domestic <del>USE</del> <u>WAS</u> 3 Feedlot 6 <u>Oil field water supply</u> 9 Dewatering 12 Other (Specify below) 2 Irrigation 4 Industrial 7 Lawn and garden only 10 Observation well Was a chemical/bacteriological sample submitted to Department? Yes _____ No _____; If yes, mo/day/yr sample was submitted _____ Water Well Disinfected? Yes _____ No _____

5 TYPE OF BLANK CASING USED: 1 Steel <u>2 PVC</u> Blank casing diameter: <u>5</u> in. to _____ ft., Dia. _____ in. to _____ ft., Dia. _____ in. to _____ ft. Casing height above land surface: <u>3</u> ft. below _____ in., weight _____ lbs./ft. Wall thickness or gauge No. _____	5 Wrought iron 3 RMP (SR) 4 ABS	6 Asbestos-Cement 7 Fiberglass	8 Concrete tile 9 Other (specify below)	CASING JOINTS: Glued _____ Clamped _____ Welded _____ Threaded _____
TYPE OF SCREEN OR PERFORATION MATERIAL: 1 Steel 2 Brass SCREEN OR PERFORATION OPENINGS ARE: 1 Continuous slot 2 Louvered shutter	3 Stainless steel 4 Galvanized steel	5 Fiberglass 6 Concrete tile	7 PVC 8 RMP (SR) 9 ABS	10 Asbestos-cement 11 Other (specify) _____ 12 None used (open hole)
SCREEN-PERFORATED INTERVALS: From _____ ft. to _____ ft., From _____ ft. to _____ ft., From _____ ft. to _____ ft.	5 Gauzed wrapped 6 Wire wrapped 7 Torch cut	8 Saw cut 9 Drilled holes 10 Other (specify) _____	11 None (open hole)	
GRAVEL PACK INTERVALS: From _____ ft. to _____ ft., From _____ ft. to _____ ft., From _____ ft. to _____ ft.				

6 GROUT MATERIAL: 1 Neat cement Grout intervals: From <u>6</u> ft. to <u>3</u> ft., From _____ ft. to _____ ft., From _____ ft. to _____ ft.	<u>2 Cement grout</u>	3 Bentonite	4 Other _____
What is the nearest source of possible contamination: 1 Septic tank 2 Sewer lines 3 Watertight sewer lines	4 Lateral lines 5 Cess pool 6 Seepage pit	7 Pit privy 8 Sewage lagoon 9 Feedyard	10 Livestock pens 11 Fuel storage 12 Fertilizer storage 13 Insecticide storage
Direction from well? <u>South</u>	14 Abandoned water well 15 <u>Oil well/Gas well</u> 16 Other (specify below) _____	How many feet? <u>60</u>	

FROM	TO	LITHOLOGIC LOG	FROM	TO	LITHOLOGIC LOG
74	25	Sand and gravel			
25	6	Clay			
6	3	Cement			

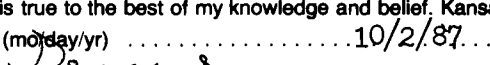7 CONTRACTOR'S OR LANDOWNER'S CERTIFICATION: This water well was (1) constructed, (2) reconstructed, or (3) <u>plugged</u> under my jurisdiction and was completed on (mo/day/year) <u>9/25/87</u> and this record is true to the best of my knowledge and belief. Kansas Water Well Contractor's License No. <u>186</u> . This Water Well Record was completed on (mo/day/yr) <u>10/2/87</u> under the business name of <u>Kelly's Water Well Service</u> by (signature) 
---

INSTRUCTIONS: Use typewriter or ball point pen. PLEASE PRESS FIRMLY and PRINT clearly. Please fill in blanks, underline or circle the correct answers. Send top three copies to Kansas Department of Health and Environment, Bureau of Water Protection, Topeka, Kansas 66620-7320, Telephone: 913-862-9360. Send one to WATER WELL OWNER and retain one for your records.

OFFICE USE ONLY  
T  
R  
EW  
SEC.  
 $\frac{1}{4}$   
 $\frac{1}{4}$   
 $\frac{1}{4}$