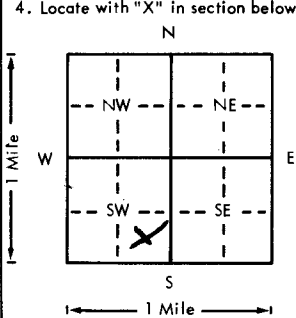


USE TYPEWRITER OR BALL POINT PEN-PRESS FIRMLY, PRINT CLEARLY.

WATER WELL RECORD  
KSA 82a-1201-1215

Kansas Department of Health and Environment-Division of Environment  
(Water well Contractors)  
Topeka, Kansas 66620

*Chalk #1*

1. Location of well: County <u>Edwards</u> Fraction <u>C 1/4 SE SW 1/4</u> Section number <u>14</u> Township number <u>T 24 S</u> Range number <u>R 17 W</u> E/W	
2. Distance and direction from nearest town or city: <u>3 1/2 west</u> Street address of well location if in city: <u>Belpre</u>	
3. Owner of well: <u>Stalwing Drilling Co</u> R.R. or street: <u>Stirling Kansas</u> City, state, zip code:	
4. Locate with "X" in section below: Sketch map: 	
5. Type and color of material	
	From To
<u>Sandy clay</u>	<u>0 20</u>
<u>Sand</u>	<u>20 35</u>
<u>Gravel</u>	<u>35 60</u>
6. Bore hole dia. <u>8</u> in. Completion date <u>4-5-78</u> Well depth <u>60</u> ft.	
7. <input checked="" type="checkbox"/> Cable tool <input checked="" type="checkbox"/> Rotary <input type="checkbox"/> Driven <input type="checkbox"/> Dug <input type="checkbox"/> Hollow rod <input type="checkbox"/> Jetted <input type="checkbox"/> Bored <input type="checkbox"/> Reverse rotary	
8. Use: <input type="checkbox"/> Domestic <input type="checkbox"/> Public supply <input type="checkbox"/> Industry <input type="checkbox"/> Irrigation <input type="checkbox"/> Air conditioning <input type="checkbox"/> Stock <input type="checkbox"/> Lawn <input checked="" type="checkbox"/> Oil field water <input type="checkbox"/> Other	
9. Casing: Material <u>Plastic</u> Height: <u>Above</u> or below Threading: <input type="checkbox"/> Threaded <input checked="" type="checkbox"/> Welded <input type="checkbox"/> Surface <u>12</u> in. RMP: <input type="checkbox"/> PVC <input checked="" type="checkbox"/> Weight <u>289.3</u> lbs./ft. Dia. <u>5</u> in. to <u>60</u> ft. depth Wall Thickness: inches or Dia. in. to ft. depth gage No. <u>200</u>	
10. Screen Manufacturer's name <u>Self made</u> Type <u>10/20</u> Dia. <u>5</u> <u>1/2</u> gauze <u>20</u> Length <u>20</u> Set between <u>40</u> ft. and <u>60</u> ft. Gravel pack? <u>yes</u> Size range of material <u>5-1/4</u>	
11. Static water level: <u>15</u> ft. below land surface Date <u>4-5-78</u> mo./day/yr.	
12. Pumping level below land surfaces: _____ ft. after _____ hrs. pumping _____ g.p.m. _____ ft. after _____ hrs. pumping _____ g.p.m. Estimated maximum yield _____ g.p.m.	
13. Water sample submitted: _____ mo./day/yr. <input type="checkbox"/> Yes <input checked="" type="checkbox"/> No Date _____	
14. Well head completion: <input type="checkbox"/> Pitless adapter _____ Inches above grade	
15. Well grouted? <u>yes</u> With: <input type="checkbox"/> Neat cement <input checked="" type="checkbox"/> Bentonite <input type="checkbox"/> Concrete Depth: From <u>0</u> ft. to <u>10</u> ft.	
16. Nearest source of possible contamination: _____ ft. _____ Direction _____ Type _____ Well disinfected upon completion? <input type="checkbox"/> Yes <input type="checkbox"/> No	
17. Pump: <input checked="" type="checkbox"/> Not installed Manufacturer's name _____ Model number _____ HP _____ Volts _____ Length of drop pipe _____ ft. capacity _____ g.p.m. Type: <input type="checkbox"/> Submersible <input type="checkbox"/> Turbine <input type="checkbox"/> Jet <input type="checkbox"/> Reciprocating <input type="checkbox"/> Centrifugal <input type="checkbox"/> Other	
(Use a second sheet if needed)	
18. Elevation: Topography: <input checked="" type="checkbox"/> Hill <input checked="" type="checkbox"/> Slope <input type="checkbox"/> Upland <input type="checkbox"/> Valley	19. Remarks:
20. Water well contractor's certification: This well was drilled under my jurisdiction and this report is true to the best of my knowledge and belief. <u>Myers Water Well</u> Business name <u>St Bend Co</u> License No. <u>143</u> Address <u>St Myers</u> <u>4-5-78</u> Signed <u>_____</u> Date <u>_____</u> Authorized representative	

T 24 S  
 R 17 W  
 Sec 14  
 1/4 1/4 1/4

Forward the white, blue and pink copies to the Department of Health and Environment

Form WWC-5