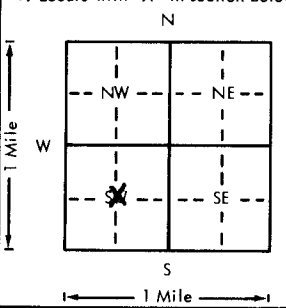


USE TYPEWRITER OR BALL POINT PEN-PRESS FIRMLY, PRINT CLEARLY.

WATER WELL RECORD  
KSA 82a-1201-1215

Kansas Department of Health and Environment-Division of Environment (Water well Contractors) Topeka, Kansas 66620

1. Location of well:		County <b>Edwards</b>	Fraction <b>1/4 C 1/4 SW 1/4</b>	Section number <b>14</b>	Township number <b>T 24 S R 17 E</b>	Range number <b>17</b>
2. Distance and direction from nearest town or city: <b>4-W 1 1/2-N of Belpre, Ks. east side</b> Street address of well location if in city:				3. Owner of well: <b>W. J. Schartz</b> R.R. or street: <b>none</b> City, state, zip code: <b>Lewis, Ks. 67552</b>		
4. Locate with "X" in section below: Sketch map: 				6. Bore hole dia. <b>29</b> in. Completion date _____ Well depth <b>78</b> ft. <b>5-20-75</b>		
5. Type and color of material				From	To	7. <input type="checkbox"/> Cable tool <input checked="" type="checkbox"/> Rotary <input type="checkbox"/> Driven <input type="checkbox"/> Dug <input type="checkbox"/> Hollow rod <input type="checkbox"/> Jetted <input type="checkbox"/> Bored <input type="checkbox"/> Reverse rotary
sandy top soil				0	3	8. Use: <input type="checkbox"/> Domestic <input type="checkbox"/> Public supply <input type="checkbox"/> Industry <input checked="" type="checkbox"/> Irrigation <input type="checkbox"/> Air conditioning <input type="checkbox"/> Stock <input type="checkbox"/> Lawn <input type="checkbox"/> Oil field water <input type="checkbox"/> Other
gray clay				3	6	9. Casing: Material <b>steel</b> Height: Above or Below _____ Threaded _____ Welded _____ Surface <b>18</b> in. RMP _____ PVC _____ Weight _____ lbs./ft. Dia. <b>16</b> in. to <b>78</b> ft. depth Wall Thickness: inches or Dia. _____ in. to _____ ft. depth gage No. <b>7</b>
brown clay				6	11	10. Screen: Manufacturer's name _____ <b>Doerrs</b> Type <b>steel</b> Dia. _____ Slot <del>3/16</del> <b>3/16</b> Length <b>40</b> Set between <b>38</b> ft. and <b>78</b> ft. _____ ft. and _____ ft. Gravel pack? <input checked="" type="checkbox"/> Size range of material <b>3/4 3/8</b>
brown & gray clay				11	18	11. Static water level: _____ mo./day/yr. <b>12</b> ft. below land surface Date <b>3-7-74</b>
fine sand & gravel				18	23	12. Pumping level below land surfaces: <b>24</b> ft. after <b>1</b> hrs. pumping <b>800</b> g.p.m. _____ ft. after _____ hrs. pumping _____ g.p.m. Estimated maximum yield <b>1600+</b> g.p.m.
yellow brown clay				23	26	13. Water sample submitted: _____ mo./day/yr. <input checked="" type="checkbox"/> Yes <input type="checkbox"/> No Date <b>3-7-74</b>
sand & gravel clean coarse loose				26	77	14. Well head completion: <input type="checkbox"/> Pitless adapter _____ Inches above grade
brown clay				77	100	15. Well grouted? <input checked="" type="checkbox"/> With: <input checked="" type="checkbox"/> Neat cement <input type="checkbox"/> Bentonite <input type="checkbox"/> Concrete Depth: From <b>0</b> ft. to <b>10</b> ft.
(Use a second sheet if needed)						16. Nearest source of possible contamination: ft. <b>5</b> mi Direction <b>south</b> Type <b>gaswell</b> Well disinfected upon completion? <input checked="" type="checkbox"/> Yes <input type="checkbox"/> No
						17. Pump: _____ Not installed Manufacturer's name <b>W.L.R.</b> Model number <b>4-12CM</b> HP <b>50</b> Volts <b>460</b> Length of drop pipe <b>50</b> ft. capacity <b>1000</b> g.p.m. Type: <input type="checkbox"/> Submersible <input checked="" type="checkbox"/> Turbine <input type="checkbox"/> Jet <input type="checkbox"/> Reciprocating <input type="checkbox"/> Centrifugal <input type="checkbox"/> Other
18. Elevation: <b>2105</b>	19. Remarks: <b>23251</b> <b>24 17 14 NCX</b>		20. Water well contractor's certification: This well was drilled under my jurisdiction and this report is true to the best of my knowledge and belief. <b>Rosencrantz-Bemis</b> <b>134</b> Business name License No. Address <b>Great Bend, Ks. 67530</b> Signed <b>S. Kilgore</b> Date <b>6-19-74</b> Authorized representative			

24 17 14 NCX

Forward the white, blue and pink copies to the Department of Health and Environment

Form WWC-5