


FERTIG 2-14

1 LOCATION OF WATER WELL: County: EDWARDS	Fraction NE 1/4 SE 1/4 SE 1/4	Section Number 14	Township Number T 24 S	Range Number R 17 E
---	---	-----------------------------	----------------------------------	-------------------------------

Distance and direction from nearest town or city street address of well if located within city?
BELPRE 2 1/2 W 4 N WESTSIDE

2 WATER WELL OWNER: STERLING DRILLING CO	WENORA FERTIG, GARFIELD KS
RR#, St. Address, Box #: BOX 129	Board of Agriculture, Division of Water Resources
City, State, ZIP Code: STERLING KS 67579	Application Number: 787-462

3 LOCATE WELL'S LOCATION WITH AN "X" IN SECTION BOX:

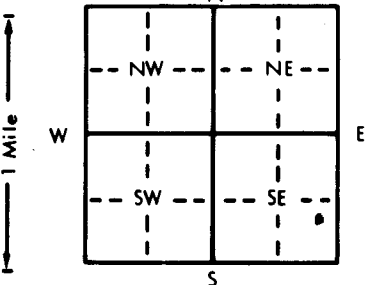

4 DEPTH OF COMPLETED WELL: 60 ft. ELEVATION:
Depth(s) Groundwater Encountered 1. 35 ft. 2. _____ ft. 3. _____ ft.
WELL'S STATIC WATER LEVEL: 31 ft. below land surface measured on mo/day/yr 9-30-83
Pump test data: Well water was _____ ft. after _____ hours pumping _____ gpm
Est. Yield _____ gpm: Well water was _____ ft. after _____ hours pumping _____ gpm
Bore Hole Diameter: 7 7/8 in. to 60 ft. and _____ in. to _____ ft.
WELL WATER TO BE USED AS:
1 Domestic 3 Feedlot 6 Oil field water supply 9 Dewatering 12 Other (Specify below)
2 Irrigation 4 Industrial 7 Lawn and garden only 10 Observation well
Was a chemical/bacteriological sample submitted to Department? Yes _____ No _____; If yes, mo/day/yr sample was submitted _____
Water Well Disinfected? Yes _____ No _____

5 TYPE OF BLANK CASING USED:	5 Wrought iron	8 Concrete tile	CASING JOINTS: Glued <input checked="" type="checkbox"/> Clamped _____
1 Steel	3 RMP (SR)	6 Asbestos-Cement	9 Other (specify below)
2 PVC	4 ABS	7 Fiberglass	10 Asbestos-cement
Blank casing diameter: 5 in. to 40 ft., Dia. _____ in. to _____ ft., Dia. _____ in. to _____ ft.			11 Injection well
Casing height above land surface: 12 in., weight 2-65 lbs./ft. Wall thickness or gauge No. 2-14			12 Other (Specify below)

TYPE OF SCREEN OR PERFORATION MATERIAL:	7 PVC	10 Asbestos-cement
1 Steel	3 Stainless steel	5 Fiberglass
2 Brass	4 Galvanized steel	6 Concrete tile
8 RMP (SR)	9 ABS	12 None used (open hole)
11 Other (specify) _____		

SCREEN OR PERFORATION OPENINGS ARE: 1/8	5 Gauzed wrapped	8 Saw cut	11 None (open hole)
1 Continuous slot	3 Mill slot	6 Wire wrapped	9 Drilled holes
2 Louvered shutter	4 Key punched	7 Torch cut	10 Other (specify) _____

SCREEN-PERFORATED INTERVALS:	From 40 ft. to 60 ft.	From _____ ft. to _____ ft.	From _____ ft. to _____ ft.
GRAVEL PACK INTERVALS:	From 31 ft. to 60 ft.	From _____ ft. to _____ ft.	From _____ ft. to _____ ft.

6 GROUT MATERIAL:	1 Neat cement	2 Cement grout	3 Bentonite	4 Other _____
Grout intervals: From 0 ft. to 10 ft.	From _____ ft. to _____ ft.	From _____ ft. to _____ ft.	From _____ ft. to _____ ft.	From _____ ft. to _____ ft.
What is the nearest source of possible contamination: NONE	10 Livestock pens	14 Abandoned water well		
1 Septic tank	4 Lateral lines	7 Pit privy	11 Fuel storage	15 Oil well/Gas well
2 Sewer lines	5 Cess pool	8 Sewage lagoon	12 Fertilizer storage	16 Other (specify below)
3 Watertight sewer lines	6 Seepage pit	9 Feedyard	13 Insecticide storage	

Direction from well? _____ How many feet? _____

FROM	TO	LITHOLOGIC LOG	FROM	TO	LITHOLOGIC LOG
0	5	SANDY SOIL			
5	12	CLAY			
12	25	SAND			
25	30	CLAY			
30	60	GRAVEL			

7 CONTRACTOR'S OR LANDOWNER'S CERTIFICATION: This water well was (1) constructed, (2) reconstructed, or (3) plugged under my jurisdiction and was completed on (mo/day/year) 9-30-83 and this record is true to the best of my knowledge and belief. Kansas Water Well Contractor's License No. 389 This Water Well Record was completed on (mo/day/yr) 10-7-83 under the business name of WEISER WATER WELL SERVICE INC by signature Rudolph Weiser
INSTRUCTIONS: Use typewriter or ball point pen, PLEASE PRESS FIRMLY and PRINT clearly. Please fill in blanks, underline or circle the correct answers. Send top three copies to Kansas Department of Health and Environment, Division of Environment, Environmental Geology Section, Topeka, KS 66620. Send one to WATER WELL OWNER and retain one for your records.

OFFICE USE ONLY
T
24 R
17
E
SEC. 14
NE 1/4 SE 1/4 SE 1/4