


CHALK #2

1 LOCATION OF WATER WELL: Fraction NE 1/4 NE 1/4 SW 1/4 Section Number 18 Township Number T 24 S Range Number R 17 E
 County: EDWARDS

Distance and direction from nearest town or city street address of well if located within city?
LEWIS 1/2 E 1 1/2 N EASTSIDE.

2 WATER WELL OWNER: STERLING DRILLING CO. LEROY CHALK, LEWIS, KS.
 RR#, St. Address, Box #: BOX 129 Board of Agriculture, Division of Water Resources
 City, State, ZIP Code: STERLING, KS 67579 Application Number: 783-697

3 LOCATE WELL'S LOCATION WITH AN "X" IN SECTION BOX:

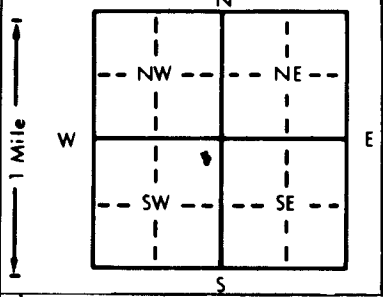

4 DEPTH OF COMPLETED WELL: 60 ft. ELEVATION:

Depth(s) Groundwater Encountered 1. 30 ft. 2. ft. 3. ft.
 WELL'S STATIC WATER LEVEL 27 ft. below land surface measured on mo/day/yr 12-6-83
 Pump test data: Well water was - ft. after hours pumping gpm
 Est. Yield gpm: Well water was - ft. after hours pumping gpm
 Bore Hole Diameter: 7 7/8 in. to 60 ft., and in. to ft.
 WELL WATER TO BE USED AS:
 5 Public water supply 8 Air conditioning 11 Injection well
 1 Domestic 3 Feedlot 6 Oil field water supply 9 Dewatering 12 Other (Specify below)
 2 Irrigation 4 Industrial 7 Lawn and garden only 10 Observation well
 Was a chemical/bacteriological sample submitted to Department? Yes.....No.....; If yes, mo/day/yr sample was submitted
 Water Well Disinfected? Yes No

5 TYPE OF BLANK CASING USED:
 1 Steel 3 RMP (SR) 5 Wrought iron 8 Concrete tile CASING JOINTS: Glued XX Clamped
 2 PVC 4 ABS 6 Asbestos-Cement 9 Other (specify below) Welded

Blank casing diameter 5 in. to 40 ft., Dia in. to ft., Dia in. to ft.
 Casing height above land surface 12 in., weight 2.65 lbs./ft. Wall thickness or gauge No. 214

TYPE OF SCREEN OR PERFORATION MATERIAL:
 1 Steel 3 Stainless steel 5 Fiberglass 7 PVC 10 Asbestos-cement
 2 Brass 4 Galvanized steel 6 Concrete tile 8 RMP (SR) 11 Other (specify)

SCREEN OR PERFORATION OPENINGS ARE: 18
 1 Continuous slot 3 Mill slot 5 Gauzed wrapped 8 Saw cut 11 None (open hole)
 2 Louvered shutter 4 Key punched 6 Wire wrapped 9 Drilled holes
 7 Torch cut 10 Other (specify)

SCREEN-PERFORATED INTERVALS: From 40 ft. to 60 ft., From ft. to ft.
 GRAVEL PACK INTERVALS: From 27 ft. to 60 ft., From ft. to ft.

6 GROUT MATERIAL: 1 Neat cement 2 Cement grout 3 Bentonite 4 Other
 Grout Intervals: From 0 ft. to 10 ft., From ft. to ft., From ft. to ft.

What is the nearest source of possible contamination: NONE
 1 Septic tank 4 Lateral lines 7 Pit privy 10 Livestock pens 14 Abandoned water well
 2 Sewer lines 5 Cess pool 8 Sewage lagoon 11 Fuel storage 15 Oil well/Gas well
 3 Watertight sewer lines 6 Seepage pit 9 Feedyard 12 Fertilizer storage 16 Other (specify below)
 13 Insecticide storage

Direction from well? How many feet?

FROM	TO	LITHOLOGIC LOG	FROM	TO	LITHOLOGIC LOG
0	5	SANDY SOIL			
5	15	SANDY CLAY			
15	25	CLAY			
25	30	CLAY			
30	60	GRAVEL			

7 CONTRACTOR'S OR LANDOWNER'S CERTIFICATION: This water well was (1) constructed, (2) reconstructed, or (3) plugged under my jurisdiction and was completed on (mo/day/year) 12-6-83 and this record is true to the best of my knowledge and belief. Kansas Water Well Contractor's License No. 389 This Water Well Record was completed on (mo/day/yr) 12-14-83 under the business name of REISER WATER WELL SERV. INC. by (signature) Rudolph J. Reiser

INSTRUCTIONS: Use typewriter or ball point pen, PLEASE PRESS FIRMLY and PRINT clearly. Please fill in blanks, underline or circle the correct answers. Send top three copies to Kansas Department of Health and Environment, Division of Environment, Environmental Geology Section, Topeka, KS 66620. Send one to WATER WELL OWNER and retain one for your records.

OFFICE USE ONLY

T

24

R

17

E

SEC.

18

NE

1/4

1/4

SW

J