USE TYPEWRITER OR BALL POINT PEN-PRESS FIRMLY, PRINT CLEARLY.

WATER WELL RECORD
KSA 82a-1201-1215

Kansas Department of Health and Environment-Division of Environment
(Water well Contractors)
Topeka, Kansas 66620

1. Location of well:	County	Fraction	Section number	Township number	Range number
	Edwards	1/4 C 1/4 NW 1/4	26	T 24 S	R 17 E/W

2. Distance and direction from nearest town or city: From Lewis, Ks. - 4 ~~E~~ - 1/4 S. - 1/4 E into field.
Street address of well location if in city:

3. Owner of well: Don McCallister
R.R. or street: RFD
City, state, zip code: Lewis, Ks. 67552

4. Locate with "X" in section below:

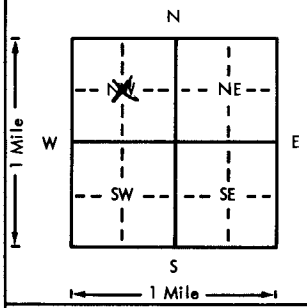

Sketch map:

6. Bore hole dia. 29 in. Completion date
Well depth 75 ft. 9-26-77

7. __ Cable tool X Rotary __ Driven __ Dug
__ Hollow rod __ Jetted __ Bored __ Reverse rotary

8. Use: __ Domestic __ Public supply __ Industry
X Irrigation __ Air conditioning __ Stock
__ Lawn __ Oil field water __ Other

9. Casing: Material steel Height: Above or ~~below~~
Threaded ___ Welded ___ Surface 18 in.
RMP ___ PVC ___ Weight ___ lbs./ft.
Dia. 16 in. to 75 ft. depth Wall Thickness: inches or
Dia. ___ in. to ___ ft. depth gage No. 7

5. Type and color of material	From	To
Sandy top soil	0	2
Fine sand	2	4
Brown clay	4	20
Sand & gravel	20	36
Gray & white clay	36	37
Sand & gravel	37	63
Hard white & yellow rock	63	69
Sand & gravel	69	74
Hard white clay & rock	74	82
Fine clay	82	85

(Use a second sheet if needed)

10. Screen: Manufacturer's name Roeco
Type Steel Dia. 16
Slot/~~gage~~ 3/16 Length 20
Set between 55 ft. and 75 ft.
___ ft. and ___ ft.
Gravel pack? X Size range of material 1/2 3/4 3/8

11. Static water level: mo./day/yr.
21.5 ft. below land surface Date 2-11-77

12. Pumping level below land surfaces:
42 ft. after 1 hrs. pumping 600 g.p.m.
___ ft. after ___ hrs. pumping ___ g.p.m.
Estimated maximum yield 1000 g.p.m.

13. Water sample submitted: mo./day/yr.
X Yes ___ No Date 2-11-77

14. Well head completion:
___ Pitless adapter ___ Inches above grade

15. Well grouted? X
With: X Neat cement ___ Bentonite ___ Concrete
Depth: From 0 ft. to 10 ft.

16. Nearest source of possible contamination:
ft. 74m Direction N E Type septic
Well disinfected upon completion? ~~HTH~~ Yes ___ No

17. Pump: ___ Not installed
Manufacturer's name W. L. R.
Model number 4-12BHC HP 60 Volts 460
Length of drop pipe 60 ft. capacity 800 g.p.m.
Type:
___ Submersible X Turbine
___ Jet ___ Reciprocating
___ Centrifugal ___ Other

18. Elevation:

Topography:
___ Hill
___ Slope
X Upland
___ Valley

19. Remarks:

20. Water well contractor's certification:
This well was drilled under my jurisdiction and this report is true to the best of my knowledge and belief.
Rosencrantz-Bemis 134
Business name License No.
Address Great Bend, Ks 67530
Signed Sandy L. Moore Date 2-26-77
Authorized representative

T 24 R 17 E/W Sec 26 1/4 C 1/4 1/4 1/4

Forward the white, blue and pink copies to the Department of Health and Environment

Form WWC-5

MI-1023