

X

OFFICE USE ONLY

T

24

R

17

EW

SEC.

28

NW 1/4

NW 1/4

NW 1/4





1 LOCATION OF WATER WELL: Fraction NW 1/4 NW 1/4 NW 1/4 Section Number 28 Township Number T 24 S Range Number R 17 EW

County: Edwards Distance and direction from nearest town or city street address of well if located within city? 2 E. Lewis Kansas

2 WATER WELL OWNER: Milton Sparks Board of Agriculture, Division of Water Resources  
 RR#, St. Address, Box #: Lewis Kansas Application Number:

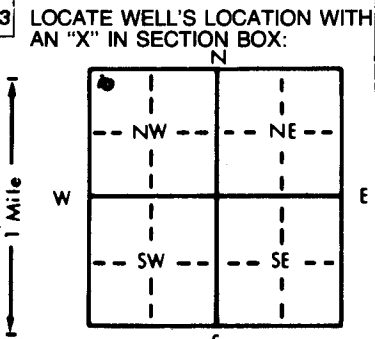

4 DEPTH OF COMPLETED WELL: 60 ft. ELEVATION:  
 Depth(s) Groundwater Encountered 1. 35 ft. 2. ft. 3. ft.  
 WELL'S STATIC WATER LEVEL 35 ft. below land surface measured on mo/day/yr 9-3-80  
 Pump test data: Well water was 35 ft. after 1 hours pumping 5 gpm  
 Est. Yield 1.5 gpm; Well water was ft. after hours pumping gpm  
 Bore Hole Diameter: 8 3/4 in. to 60 ft., and in. to ft.  
 WELL WATER TO BE USED AS:  
 1 Domestic     3 Feedlot     6 Oil field water supply     9 Dewatering     12 Other (Specify below)  
 2 Irrigation     4 Industrial     7 Lawn and garden only     10 Observation well  
 Was a chemical/bacteriological sample submitted to Department? Yes No X; If yes, mo/day/yr sample was submitted  
 Water Well Disinfected? Yes X No

5 TYPE OF BLANK CASING USED:  
 1 Steel     3 RMP (SR)    5 Wrought iron    8 Concrete tile    CASING JOINTS: Glued X Clamped  
 2 PVC    4 ABS    6 Asbestos-Cement    9 Other (specify below)    Welded  
 7 Fiberglass    Threaded  
 Blank casing diameter 5 in. to 40 ft., Dia in. to ft., Dia in. to ft.  
 Casing height above land surface 12 in., weight 1.75 lbs./ft. Wall thickness or gauge No. SDR-26  
 TYPE OF SCREEN OR PERFORATION MATERIAL:  
 1 Steel    3 Stainless steel    5 Fiberglass     8 RMP (SR)    10 Asbestos-cement  
 2 Brass    4 Galvanized steel    6 Concrete tile    9 ABS    11 Other (specify)  
 12 None used (open hole)  
 SCREEN OR PERFORATION OPENINGS ARE:  
 1 Continuous slot    3 Mill slot    5 Gauzed wrapped     8 Saw cut    11 None (open hole)  
 2 Louvered shutter    4 Key punched    6 Wire wrapped    9 Drilled holes  
 7 Torch cut    10 Other (specify)  
 SCREEN-PERFORATED INTERVALS: From 40 ft. to 60 ft., From ft. to ft., From ft. to ft.  
 GRAVEL PACK INTERVALS: From 30 ft. to 60 ft., From ft. to ft., From ft. to ft.

6 GROUT MATERIAL:  1 Neat cement    2 Cement grout    3 Bentonite    4 Other  
 Grout intervals: From 4 ft. to 14 ft., From ft. to ft., From ft. to ft.  
 What is the nearest source of possible contamination:  
 1 Septic tank    4 Lateral lines    7 Pit privy    10 Livestock pens    14 Abandoned water well  
 2 Sewer lines    5 Cess pool    8 Sewage lagoon    11 Fuel storage    15 Oil well/Gas well  
 3 Watertight sewer lines    6 Seepage pit    9 Feedyard    12 Fertilizer storage    16 Other (specify below)  
 13 Insecticide storage  
 Direction from well? NW How many feet? 60

FROM	TO	LITHOLOGIC LOG	FROM	TO	LITHOLOGIC LOG
0	2	Top Soil			
2	17	Clay			
17	57	Gravel			
57	60	Clay			

7 CONTRACTOR'S OR LANDOWNER'S CERTIFICATION: This water well was  (1) constructed, (2) reconstructed, or (3) plugged under my jurisdiction and was completed on (mo/day/year) 9-3-80 and this record is true to the best of my knowledge and belief. Kansas Water Well Contractor's License No. 224 This Water Well Record was completed on (mo/day/yr) 12-26-81 under the business name of Carl Hayes Water Well Serv. by (signature) Carl Hayes  
 INSTRUCTIONS: Use typewriter or ball point pen PLEASE PRESS FIRMLY and PRINT clearly. Please fill in blanks, underline or circle the correct answers. Send top three copies to Kansas Department of Health and Environment, Division of Environment, Environmental Geology Section, Topeka, KS 66620. Send one to WATER WELL OWNER and retain one for your records.