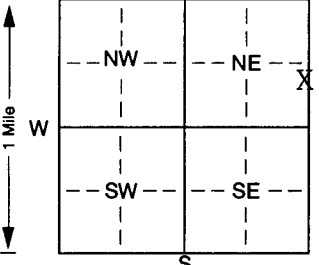


1 LOCATION OF WATER WELL: County: <u>Edwards</u>	Fraction <u>¼ CE ¼ NE ¼</u>	Section Number <u>29</u>	Township Number <u>T 24 S</u>	Range Number <u>R 17 E/W</u>
---	--------------------------------	-----------------------------	----------------------------------	---------------------------------

Distance and direction from nearest town or city street address of well if located within city?
2½ East, ¼ South of Lewis

2 WATER WELL OWNER: Cross ~~KXXXX~~ Family Trust (Bank of America)
 RR#, St. Address, Box # : P.O. Box 47428
 City, State, ZIP Code : Wichita, Ks. 67201
 Board of Agriculture, Division of Water Resources
 Application Number: #27,647

3 LOCATE WELL'S LOCATION WITH AN "X" IN SECTION BOX: 	4 DEPTH OF COMPLETED WELL... <u>93</u> ft. ELEVATION: ft. Depth(s) Groundwater Encountered 1. ft. 2. ft. 3. ft. WELL'S STATIC WATER LEVEL... <u>44</u> ft. below land surface measured on mo/day/yr ... XXX <u>5-30-03</u> Pump test data: Well water was <u>68</u> ft. after <u>1½</u> hours pumping ... <u>500</u> gpm Est. Yield ... <u>600</u> gpm: Well water was <u>74</u> ft. after <u>2</u> hours pumping ... <u>600</u> gpm Bore Hole Diameter... <u>30</u> in. to <u>93</u> ft., and in. to ft. WELL WATER TO BE USED AS: 5 Public water supply 8 Air conditioning 11 Injection well 1 Domestic 3 Feedlot 6 Oil field water supply 9 Dewatering 12 Other (Specify below) 2 <u>Irrigation</u> 4 Industrial 7 Domestic (lawn & garden) 10 Monitoring well Was a chemical/bacteriological sample submitted to Department? Yes. No. <u>X</u> ; If yes, mo/day/yr sample was submitted Water Well Disinfected? Yes <u>HTH</u> No
--	---

5 TYPE OF BLANK CASING USED:
 1 Steel 3 RMP (SR) 5 Wrought iron 8 Concrete tile CASING JOINTS: Glued. X Clamped.
 2 PVC 4 ABS 6 Asbestos-Cement 9 Other (specify below) Welded
 7 Fiberglass Threaded.
 Blank casing diameter 16 in. to 68 ft., Dia 16 in. to 93 ft., Dia in. to ft.
 Casing height above land surface 24 in., weight Sch 40 lbs./ft. Wall thickness or gauge No.
 TYPE OF SCREEN OR PERFORATION MATERIAL:
 1 Steel 3 Stainless steel 5 Fiberglass 7 PVC 10 Asbestos-cement
 2 Brass 4 Galvanized steel 6 Concrete tile 8 RMP (SR) 11 Other (specify)
 12 None used (open hole)
 SCREEN OR PERFORATION OPENINGS ARE:
 1 Continuous slot 3 Mill slot 5 Gauzed wrapped 8 Saw cut 11 None (open hole)
 2 Louvered shutter 4 Key punched 6 Wire wrapped 9 Drilled holes
 7 Torch cut 10 Other (specify) ft.
 SCREEN-PERFORATED INTERVALS: From 88 ft. to 68 ft., From ft. to ft.
 From ft. to ft., From ft. to ft.
 GRAVEL PACK INTERVALS: From 93 ft. to 20 ft., From ft. to ft.
 From ft. to ft., From ft. to ft.

6 GROUT MATERIAL: 1 Neat cement 2 Cement grout 3 Bentonite 4 Other hole plug
 Grout Intervals: From 20 ft. to 0 ft., From ft. to ft., From ft. to ft.
 What is the nearest source of possible contamination:
 1 Septic tank 4 Lateral lines 7 Pit privy 10 Livestock pens 14 Abandoned water well
 2 Sewer lines 5 Cess pool 8 Sewage lagoon 11 Fuel storage 15 Oil well/Gas well
 3 Watertight sewer lines 6 Seepage pit 9 Feedyard 12 Fertilizer storage 16 Other (specify below)
 None
 Direction from well? How many feet?

FROM	TO	LITHOLOGIC LOG	FROM	TO	PLUGGING INTERVALS
0	3	Top soil			
3	7	Brown clay			
7	16	Sandy brown & gray clay			
16	24½	Fine sand			
24½	25½	Tan clay			
25½	55	Sand & gravel coarse, med, loose			
55	61	Gray & yellow clay			
61	66	Sand & gravel small, rusty color			
66	68	Gray clay			
68	77½	Sand & gravel small, tight			
77½	79	Tan & gray clay			
79	84½	Sand & gravel small, tight			
84½	88	Tan clay			
88	93	Sand & gravel/ clay streaks			

7 CONTRACTOR'S OR LANDOWNER'S CERTIFICATION: This water well was (1) constructed, (2) reconstructed, or (3) plugged under my jurisdiction and was completed on (mo/day/year) 6-10-03 and this record is true to the best of my knowledge and belief. Kansas Water Well Contractor's Licence No. 134 This Water Well Record was completed on (mo/day/yr)
 under the business name of Rosencrantz- Bemis by (signature) Xora Albo