


WATER WELL RECORD Form WWC-5 KSA 82a-1212

1 LOCATION OF WATER WELL: Fraction Section Number Township Number Range Number  
 COUNTY: EDWARDS SE 1/4 NE 1/4 SE 1/4 22 T 24 S R 17 W

Distance and direction from nearest town or city street address of well if located within city?  
 5 MILES EAST, .3 MILE NORTH OF LEWIS

2 WATER WELL OWNER: CROSS, DAVID Board of Agriculture, Division of Water Resources  
 RR#, St. Address, Box #: RR 1  
 City, State, ZIP code: LEWIS, KS 67552- Application Number:

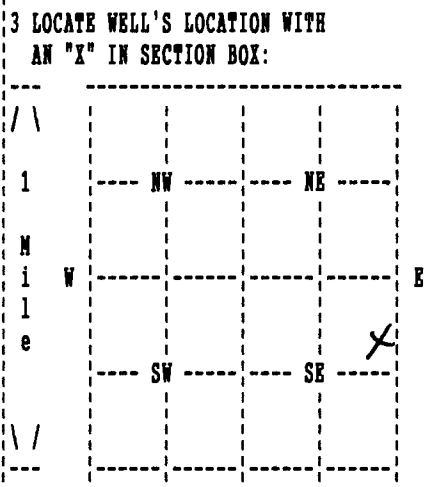

4 DEPTH OF COMPLETED WELL 82 ELEVATION: 0  
 Depth(s) Groundwater Encountered 1. 0 ft. 2. 0 ft. 3. 0 ft.  
 WELL'S STATIC WATER LEVEL 45 ft. below land surface measured on mo/day/yr 02/04/03  
 Pump testdata: Well water was 0 ft. after 0 hours pumping 0 gpm  
 Estimated Yield 0 gpm: Well water was 0 ft. after 0 hours pumping 0 gpm  
 Bore Hole Diameter 8.75 in. to 82 ft., and in. to 0 ft.  
 WELL WATER TO BE USED AS: LIVESTOCK  
 Was a chemical/bacteriological sample submitted to department? No ;  
 If yes, mo/day/yr sample was submitted Water well disinfected? Yes

5 TYPE OF BLANK CASING USED: PVC CASING JOINTS: GLUED  
 Blank casing diameter 5 in. to 72 ft., Dia in. to 0 ft., Dia in. to 0 ft.  
 Casing height above land surface 12 in., weight 0 lbs/ft. Wall thickness or gauge No. 26  
 TYPE OF SCREEN OR PERFORATION MATERIAL: PVC  
 SCREEN OR PERFORATION OPENINGS ARE: SAW CUT

SCREEN PERFORATED INTERVALS: From 72 ft. to 82 ft., From 0 ft. to 0 ft.  
 From 0 ft. to 0 ft., From 0 ft. to 0 ft.  
 GRAVEL PACK INTERVALS: From 23 ft. to 82 ft., From 0 ft. to 0 ft.  
 From 0 ft. to 0 ft., From 0 ft. to 0 ft.

6 GROUT MATERIAL BENTONITE  
 Grout Intervals: From 2 ft. to 23 ft., From 0 ft. to 0 ft., From 0 ft. to 0 ft.  
 What is the nearest source of possible contamination: LIVESTOCK PENS  
 Direction from well? WEST How many feet? 3000

FROM	TO	LITHOLOGIC LOG	FROM	TO	PLUGGING INTERVALS
0	3	SILT AND SAND			
3	31	TAN CLAY			
31	81	SAND AND GRAVEL			
81	82	TAN CLAY			

7 CONTRACTOR'S OR LANDOWNER'S CERTIFICATION: This water well was Constructed under my jurisdiction and was completed on (mo/day/year) 02/04/03 and this record is true to the best of my knowledge and belief. Kansas Water Well Contractor's License No. 653 This Water Well Record was completed on (mo/day/yr) 06/05/03 under the business name of DAN HAYSE WATER WELL SVC. by (signature)