


1 LOCATION OF WATER WELL: Fraction $\frac{1}{4}$ $\frac{1}{4}$ NC $\frac{1}{4}$ NE $\frac{1}{4}$
 County: **Edwards** Section Number **34** Township No. T **24** S Range Number R **17** E W
 Street/Rural Address of Well Location; if unknown, distance & direction from nearest town or intersection: If at owner's address, check here
 Approximately **1 3/4** miles south and **4 1/4** miles west of **Belpre**

2 WATER WELL OWNER: **Wayne Miller**
 RR#, Street Address, Box #: **1104 300th Ave.**
 City, State, ZIP Code : **Macksville, KS 67557**

Global Positioning System (GPS) information:
 Latitude: **37.923435** (in decimal degrees)
 Longitude: **-99.173669** (in decimal degrees)
 Elevation: **unknown**
 Datum: WGS 84, NAD 83, NAD 27
 Collection Method:
 GPS unit (Make/Model: **WAAS**)
 Digital Map/Photo, Topographic Map, Land Survey
 Est. Accuracy: <3 m, 3-5 m, 5-15 m, >15 m

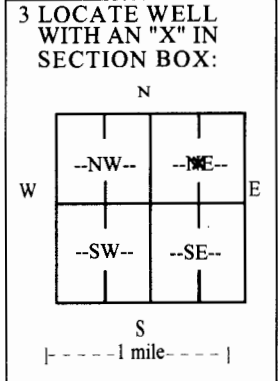

4 DEPTH OF COMPLETED WELL **156.8** ft.
 Depth(s) Groundwater Encountered (1) _____ ft. (2) _____ ft. (3) _____ ft.
 WELL'S STATIC WATER LEVEL **41.5** ft. below land surface measured on mo/day/yr **3/10/11**
 Pump test data: Well water was not checked ft. after _____ hours pumping _____ gpm
 EST. YIELD **unknown** gpm. Well water was _____ ft. after _____ hours pumping _____ gpm
 Bore Hole Diameter **24** in. to **156** ft., and _____ in. to _____ ft.
 WELL WATER TO BE USED AS: Public water supply Geothermal Injection well
 Domestic Feedlot Oil field water supply Dewatering Other (Specify below)
 Irrigation Industrial Domestic-lawn & garden Monitoring well
 Was a chemical/bacteriological sample submitted to Department? Yes No
 If yes, mo/day/yr sample was submitted _____
 Water well disinfected? Yes No

5 TYPE OF CASING USED: Steel PVC Other
 CASING JOINTS: Glued Clamped Welded Threaded
 Casing diameter **16** in. to **69** ft., Diameter **16** in. to **135** ft., Diameter _____ in. to _____ ft.
 Casing height above land surface **21** in., Weight **19.75** lbs./ft., Wall thickness or gauge No. **.616**
 TYPE OF SCREEN OR PERFORATION MATERIAL:
 Steel Stainless Steel PVC Other (Specify) _____
 Brass Galvanized Steel None used (open hole)
 SCREEN OR PERFORATION OPENINGS ARE:
 Continuous slot Mill slot Gauze wrapped Torch cut Drilled holes None (open hole)
 Louvered shutter Key punched Wire wrapped Saw cut Other (specify) _____
 SCREEN-PERFORATED INTERVALS: From **69** ft. to **84 (S.S.)** ft., From _____ ft. to _____ ft.
 From **135** ft. to **155 (PVC)** ft., From _____ ft. to _____ ft.
 GRAVEL PACK INTERVALS: From **23** ft. to **156** ft., From _____ ft. to _____ ft.
 From _____ ft. to _____ ft., From _____ ft. to _____ ft.

6 GROUT MATERIAL: Neat cement Cement grout Bentonite Other **Concrete Well Pad**
 Grout Intervals: From _____ ft. to _____ ft., From **3** ft. to **23** ft., From **0** ft. to **3** ft.
 What is the nearest source of possible contamination:
 Septic tank Lateral lines Pit privy Livestock pens Insecticide storage Other (specify below)
 Sewer lines Cesspool Sewage lagoon Fuel storage Abandoned water well
 Watertight sewer lines Seepage pit Feedyard Fertilizer storage Oil well/gas well **None known**
 Direction from well _____ Distance from well _____

FROM	TO	LITHOLOGIC LOG	FROM	TO	LITHO. LOG (cont.) or PLUGGING INTERVALS
0	6	Topsoil, sand	135	155	Sand and gravel, fine to medium, some clay streaks
6	11	Clay, sandy, brown			
11	17	Clay, gray, brown	155	156	Clay, tan
17	31	Clay, gray, brown, with sand, fine, gravel streaks, fine			
31	50	Sand and gravel, fine to medium, some coarse, thin clay streaks, tan			
50	84	Sand, gravel, fine to coarse			
84	130	Clay, tan, white, caliche			
130	135	Clay, tan, with sand, 50/50			

7 CONTRACTOR'S OR LANDOWNER'S CERTIFICATION: This water well was constructed, reconstructed, or plugged under my jurisdiction and was completed on (mo/day/year) **3/10/11** and this record is true to the best of my knowledge and belief.
 Kansas Water Well Contractor's License No. **185** This Water Well Record was completed on (mo/day/year) **3/15/11**
 under the business name of **Clarke Well & Equipment, Inc.** by (signature) _____

INSTRUCTIONS: Use typewriter or ball point pen. PLEASE PRESS FIRMLY and PRINT clearly. Please fill in blanks and check the correct answers. Send three copies (white, blue, pink) to Kansas Department of Health and Environment, Bureau of Water, Geology Section, 1000 SW Jackson St., Suite 420, Topeka, Kansas 66612-1367. Telephone 785-296-5522. Send one copy to WATER WELL OWNER and retain one for your records. Include fee of \$5.00 for each constructed well. Visit us at <http://www.kdheks.gov/waterwell/index.html>.