

WATER WELL RECORD Form WWC-5 KSA 82a-1212

1 LOCATION OF WATER WELL: Fraction Section Number Township Number Range Number  
 COUNTY: 024 EDWARDS NW 1/4 NW 1/4 NW 1/4 34 T 24 S R 17 W

Distance and direction from nearest town or city street address of well if located within city?

4 E. 1 1 S. OF LEWIS, KS

2 WATER WELL OWNER: CROSS BROTHERS 297


RR#, St. Address, Box #: RR

Board of Agriculture, Division of Water Resources

City, State, ZIP code : LEWIS, KS 67552-

Application Number:

3 LOCATE WELL'S LOCATION WITH AN "X" IN SECTION BOX:

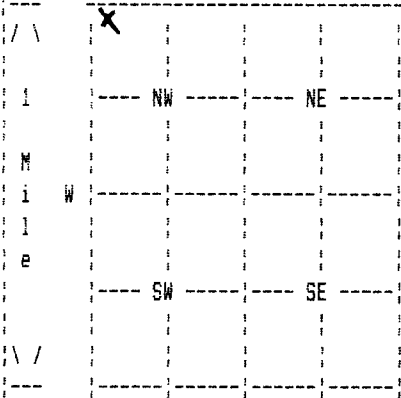

4 DEPTH OF COMPLETED WELL 80 ELEVATION: 0  
 Depth(s) Groundwater Encountered 1. 40 ft. 2. 0 ft. 3. 0 ft.

WELL'S STATIC WATER LEVEL 40 ft. below land surface measured on mo/day/yr  
 Pump test data: Well water was 0 ft. after 0 hours pumping 0 gpm

Estimated Yield 0 gpm: Well water was 0 ft. after 0 hours pumping 0 gpm

Bore Hole Diameter 8.75 in. to 80 ft., and in. to 0 ft.

WELL WATER TO BE USED AS: 01 DOMESTIC

Was a chemical/bacteriological sample submitted to department? No ;  
 If yes, mo/day/yr sample was submitted Water well disinfected? Yes

5 TYPE OF BLANK CASING USED: 02 PVC CASING JOINTS: GLUED

Blank casing diameter 5 in. to 74 ft., Dia in. to 0 ft., Dia in. to 0 ft.

Casing height above land surface 12 in., weight 0 lbs/ft. Wall thickness or gauge No. 26

TYPE OF SCREEN OR PERFORATION MATERIAL: 07 PVC

SCREEN OR PERFORATION OPENINGS ARE: 08 SAW CUT

SCREEN PERFORATED INTERVALS: From 71 ft. to 81 ft., From 0 ft. to 0 ft.

From 0 ft. to 0 ft., From 0 ft. to 0 ft.

GRAVEL PACK INTERVALS: From 25 ft. to 80 ft., From 0 ft. to 0 ft.

From 0 ft. to 0 ft., From 0 ft. to 0 ft.

6 GROUT MATERIAL 03 BENTONITE

Grout Intervals: From 0 ft. to 25 ft., From 0 ft. to 0 ft., From 0 ft. to 0 ft.

What is the nearest source of possible contamination: CATTLE PASTURE

Direction from well? ALL How many feet? 4

FROM	TO	LITHOLOGIC LOG	FROM	TO	PLUGGING INTERVALS
0	28	GREY CLAY			
28	68	05 SAND AND 17 GRAVEL			
68	70	TAN CLAY			
70	81	05 SAND AND 17 GRAVEL			

7 CONTRACTOR'S OR LANDOWNER'S CERTIFICATION: This water well was Constructed under my jurisdiction and was completed on (mo/day/year) 12/12/94 and this record is true to the best of my knowledge and belief. Kansas

Water Well Contractor's License No. 224 This Water Well Record was completed on (mo/day/yr) 12/18/94

under the business name of CARL HAYSE WATER WELL SVC by (signature) Carl Hayse