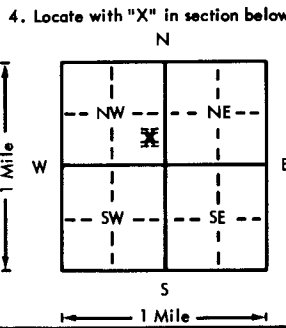


USE TYPEWRITER OR BALL POINT PEN-PRESS FIRMLY, PRINT CLEARLY.

WATER WELL RECORD
KSA 82a-1201-1215

Kansas Department of Health and Environment-Division of Environment
(Water well Contractors)
Topeka, Kansas 66620

1. Location of well:	County Edwards	Fraction se 1/4 se 1/4 se 1/4	Section number 4	Township number T 24 S	Range number R 18 W E/W
2. Distance and direction from nearest town or city: 2 miles west and 5 north of Lewis, Kansas Street address of well location if in city:			3. Owner of well: Leonard Temaat R.R. or street: Spearville, Kansas 67876 City, state, zip code:		
4. Locate with "X" in section below: <div style="text-align: center;">  </div>			Sketch map: Pasture X ↓ ↓		
5. Type and color of material			From	To	6. Bore hole dia. 5 in. Completion date 1-19-76 Well depth 35 ft.
Fine sand			0	5	7. <input checked="" type="checkbox"/> Cable tool <input checked="" type="checkbox"/> Rotary <input type="checkbox"/> Driven <input type="checkbox"/> Dug <input type="checkbox"/> Hollow rod <input type="checkbox"/> Jetted <input type="checkbox"/> Bored <input type="checkbox"/> Reverse rotary
Fine sand and brown clay			5	11	8. Use: <input type="checkbox"/> Domestic <input type="checkbox"/> Public supply <input type="checkbox"/> Industry <input type="checkbox"/> Irrigation <input type="checkbox"/> Air conditioning <input checked="" type="checkbox"/> Stock <input type="checkbox"/> Lawn <input type="checkbox"/> Oil field water <input type="checkbox"/> Other
A-1 course sand and gravel			11	35	9. Casing: Material pits Height: above below Threaded <input type="checkbox"/> Welded gl Surface 12 in. RMP <input checked="" type="checkbox"/> PVC <input type="checkbox"/> Weight _____ lbs./ft. Dia. 5 in. to 35 ft. depth Wall Thickness: _____ inches or Dia. _____ in. to _____ ft. depth gage No. 0.250
					10. Screen: Manufacturer's name Jess and Lowell Type RMP Dia. 5 in Slot/gauze 1/16 Length 20 Set between 15 ft. and 35 ft. Gravel pack? yes Size range of material 1/4-1/8
					11. Static water level: _____ mo./day/yr. 12 ft. below land surface Date 1-20-76
					12. Pumping level below land surfaces: _____ ft. after _____ hrs. pumping _____ g.p.m. _____ ft. after _____ hrs. pumping _____ g.p.m. Estimated maximum yield _____ g.p.m.
					13. Water sample submitted: _____ mo./day/yr. Yes <input type="checkbox"/> No <input type="checkbox"/> Date _____
					14. Well head completion: <input type="checkbox"/> Pitless adapter _____ Inches above grade
					15. Well grouted? yes With: <input type="checkbox"/> Neat cement <input checked="" type="checkbox"/> Bentonite <input type="checkbox"/> Concrete Depth: From _____ ft. to 10 ft.
					16. Nearest source of possible contamination: nc ft. _____ Direction _____ Type _____ Well disinfected upon completion? <input type="checkbox"/> Yes <input checked="" type="checkbox"/> No
					17. Pump: _____ Not installed Manufacturer's name _____ Model number _____ HP _____ Volts _____ Length of drop pipe _____ ft. capacity _____ g.p.m. Type: <input type="checkbox"/> Submersible <input type="checkbox"/> Turbine <input type="checkbox"/> Jet <input type="checkbox"/> Reciprocating <input type="checkbox"/> Centrifugal <input type="checkbox"/> Other
			(Use a second sheet if needed)		
18. Elevation:	19. Remarks:		20. Water well contractor's certification: This well was drilled under my jurisdiction and this report is true to the best of my knowledge and belief. Hodde Drilling Comp. 302 Business name _____ License No. _____ Address R.R. # 1 Signed Phillie Hodde Date 1-28-76 Authorized representative		
Topography: <input type="checkbox"/> Hill <input checked="" type="checkbox"/> Slope <input type="checkbox"/> Upland <input type="checkbox"/> Valley			24 18 4 SESESE 1/4 1/4 1/4 1/4 Sec		

Forward the white, blue and pink copies to the Department of Health and Environment

Form WWC-5

4-16-75

Kansas Dept. of Health & Environment
Water well contractors
Topeka, Kansas

This is to inform you that the following pump was
installed for Leonard Temaatt

Edwards Co, Wayne township, center NW $\frac{1}{4}$ section 4, T-24-S
R-18-W on the 4-14-75

Goulds 12JLO
140' of drop pipe
Set his 90 HP gear drive
800 GPM at 80 PSI



Ace-Hi Drilling Co 190

Carl G. Fittl