USE TYPEWRITER OR BALL POINT PEN-PRESS FIRMLY, PRINT CLEARLY.

T R EW sec 1/4 1/4 1/4 No.

WATER WELL RECORD
KSA 82a-1201-1215

Kansas State Dept. Of Health
(Water Well Contractors)
Forbes-Bldg. 740
Topeka, Kansas 66620

1 Location of well:	County	Township name	Fraction	Section number	Town number	Range number
	Edwards	Wayne	Center NW¼	4	T-24	R-18-W

Distance and direction from nearest town or city: 4 mi. north-~~4~~ west of Lewis, Kansas

Street address of well location if in city:

3 Owner of well: Leonard Temaat

Address: Spearville, Kansas

Locate with "X" in section below:

Sketch map:

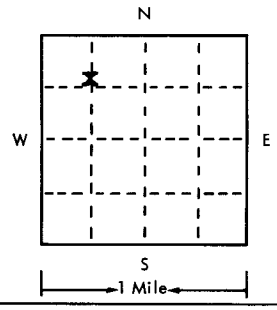

2 Type and color of material	From	To
Surface	0	3
Fine sand	3	10
A-1 sand and gravel	10	35
Soft brown and gray clay	35	75
Soft blue clay	75	95
Brown clay	95	105
Clay with 10% sandrock mixed	105	115
Gray shale	115	130
A-1 tan and brown sandstone	130	200
Blue shale and rock layers	200	260
Pump should be set in late March or early April		
(use a second sheet if needed)		

4 Well depth: 206 ft. Date of completion 3-14-75
Well diameter 28 in.

5 ☐ Cable tool ☐ Rotary ☐ Driven ☐ Dug ☐ Hollow rod ☐ Jetted ☐ Bored ☒ Reverse rotary

6 Use: ☐ Domestic ☐ Public supply ☐ Industry ☒ Irrigation ☐ Air conditioning ☐ Commercial ☐ Test well ☐ ____

7 Casing: Material ~~Metal~~ Height: above/below Surface 14 in.
Threaded ☐ Welded ☒ Weight 30.30 lbs./ft.
Diam. 16 ~~16~~ in. to 206 ft. depth
Drive shoe? ☐ Yes ☒ No
____ in. to ____ ft. depth

8 Screen: 10' cook screen
Manufacturer Free-flo (W.A. Brown)
Type 10% & 35% Dia. 16 in
Slot/gauze 1/8 Length 2 in
Set between 14 ft. and 38 ft. 106 & 206
Fittings:
Gravel pack ☒ Yes ☐ No Size range of material ½

9 Static water level: 8 ft. below land surface Date 3-14-75

10 Pumping level below land surfaces: 50 ft. after 4 hrs. pumping 1500 g.p.m.
____ ft. after ____ hrs. pumping ____ g.p.m.
Estimated maximum yield 2000 g.p.m.

11 Water sample submitted: ☐ Yes ☒ No Date ____

12 Well head completion: ☐ Pitless adapter ☒ Inches above grade

13 Well grouted? ☒ Yes ☐ No
☒ Neat cement ☐ Bentonite ☐ ____
Depth: From 0 ft. to 10 ft.

14 Nearest source of possible contamination: NA
ft. ____ Direction ____ Type ____
Well disinfected upon completion? ☐ Yes ☒ No

15 Pump: Ordered ☒ Not installed
Manufacturer's name Goulds
Model number 12JLO HP 60 Volts ____
Length of drop pipe 140 ft. capacity 800 g.m.p.
Type: ☐ Submersible ☒ Turbine ☐ Jet ☐ Reciprocating ☐ Certrifugal ☐ Other

16 Remarks: elevation 2115 23870
2418 NBX

Topography: ☐ Hill ☐ Slope ☐ Upland ☒ Valley

17 Water well contractor's certification:
This well was drilled under my jurisdiction and this report is true to the best of my knowledge and belief.
Ace-Hi Drilling Co 190
Business name License No.
Address Box 1442, Dodge City, Ks
Signed Earl Coffel Date 3-12-75
Authorized representative

Forward the white, blue and pink copies to the Kansas State Dept. Of Health.

Form WWC-5

677-H