USE TYPEWRITER OR BALL POINT PEN-PRESS FIRMLY, PRINT CLEARLY.

WATER WELL RECORD
KSA 82a-1201-1215

Kansas Department of Health and Environment-Division of Environment
(Water well Contractors)
Topeka, Kansas 66620

1. Location of well:	County Edwards [redacted]	Fraction WE1/4NE1/4NE1/4	Section number 5	Township number T 24 S	Range number R 18 E/W

Distance and direction from nearest town or city: 6 NE Kinsley
Street address of well location if in city:

3. Owner of well: Jerome Fox
R.R. or street: RFD 1
City, state, zip code: Kinsley, Kansas 67547

4. Locate with "X" in section below:

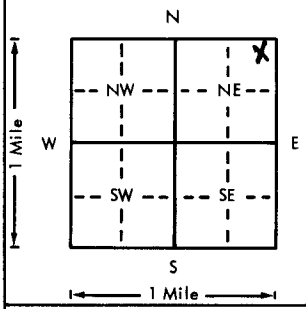

Sketch map: Well # 1

6. Bore hole dia. 29 in. Completion date _____
Well depth 33 ft. 9-19-77

7. __ Cable tool X Rotary __ Driven __ Dug
__ Hollow rod __ Jetted __ Bored __ Reverse rotary

8. Use: __ Domestic __ Public supply __ Industry
X Irrigation __ Air conditioning __ Stock
__ Lawn __ Oil field water __ Other

9. Casing: Material steel Height: Above or ~~below~~
Threaded ____ Welded ____ Surface 18 in.
RMP ____ PVC ____ Weight ____ lbs./ft.
Dia. 16 in. to 33 ft. depth Wall Thickness: inches or
Dia. ____ in. to ____ ft. depth gage No. 7

10. Screen: Manufacturer's name Doerrs
Type steel Dia. 16
Slot ~~gage~~ 3/16 Length 10
Set between 23 ft. and 33 ft.
____ ft. and ____ ft.
Gravel pack? X Size range of material ~~1/8~~ 3/4 3/8

11. Static water level: mo./day/yr.
14 ft. below land surface Date 3-19-77

12. Pumping level below land surfaces:
28 ft. after 1 hrs. pumping 250 g.p.m.
____ ft. after ____ hrs. pumping ____ g.p.m.
Estimated maximum yield ____ g.p.m.

13. Water sample submitted: mo./day/yr.
X Yes ____ No Date 3-19-77

14. Well head completion:
____ Pitless adapter ____ Inches above grade

15. Well grouted? X
With: X Neat cement ____ Bentonite ____ Concrete
Depth: From 0 ft. to 10 ft.

16. Nearest source of possible contamination:
ft. ____ Direction ____ Type ____
Well disinfected upon completion? HTH Yes ____ No

17. Pump: X Not installed
Manufacturer's name ____
Model number ____ HP ____ Volts ____
Length of drop pipe ____ ft. capacity ____ g.p.m.
Type:
____ Submersible ____ Turbine
____ Jet ____ Reciprocating
____ Centrifugal ____ Other

5. Type and color of material	From	To
Top soil	0	1
Clay	1	3
Sand	3	6
Gravel	6	32
Clay	32	40

(Use a second sheet if needed)

18. Elevation:

Topography:
____ Hill
____ Slope
X Upland
____ Valley

19. Remarks:

20. Water well contractor's certification:
This well was drilled under my jurisdiction and this report is true to the best of my knowledge and belief.
Rosencrantz-~~Bemis~~ Bemis 134
Business name License No.
Address Great Bend, Kansas 67530
Signed Sandy Kilgore Date 12-7-77
Authorized representative

T 24 R 18 E/W Sec 5 1/4 NE 1/4 NE 1/4

Forward the white, blue and pink copies to the Department of Health and Environment

Form WWC-5

MI-1023