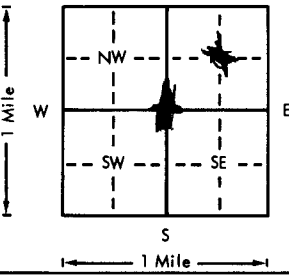
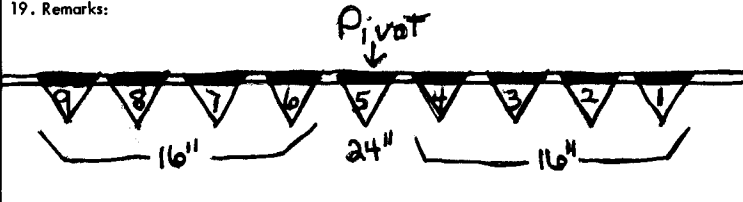


USE TYPEWRITER OR BALL POINT PEN-PRESS FIRMLY, PRINT CLEARLY.

WATER WELL RECORD
KSA 82a-1201-1215

Kansas Department of Health and Environment-Division of Environment
(Water well Contractors)
Topeka, Kansas 66620

1. Location of well:	County Edwards	Fraction 1/4 C 1/4 NE 1/4	Section number 5	Township number T 24 S	Range number R 18 E/W
2. Distance and direction from nearest town or city: Street address of well location if in city: 6 NE Kinsley			3. Owner of well: R.R. or street: City, state, zip code: Jerome Fox RFD 1 Kinsley, Kansas 67547		
4. Locate with "X" in section below: Sketch map: 			6. Bore hole dia. <u>29</u> in. Completion date _____ Well depth <u>30</u> ft. <u>9-19-77</u>		
5. Type and color of material			7. <input type="checkbox"/> Cable tool <input checked="" type="checkbox"/> Rotary <input type="checkbox"/> Driven <input type="checkbox"/> Dug <input type="checkbox"/> Hollow rod <input type="checkbox"/> Jetted <input type="checkbox"/> Bored <input type="checkbox"/> Reverse rotary		
			8. Use: <input type="checkbox"/> Domestic <input type="checkbox"/> Public supply <input type="checkbox"/> Industry <input checked="" type="checkbox"/> Irrigation <input type="checkbox"/> Air conditioning <input type="checkbox"/> Stock <input type="checkbox"/> Lawn <input type="checkbox"/> Oil field water <input type="checkbox"/> Other		
From To			9. Casing: Material <u>steel</u> Height: Above or <u>below</u> Threaded <input type="checkbox"/> Welded <input type="checkbox"/> Surface <u>18</u> in. RMP <input type="checkbox"/> PVC <input type="checkbox"/> Weight _____ lbs./ft. Dia. <u>2 1/2</u> in. to <u>30</u> ft. depth Wall Thickness: inches or Dia. _____ in. to _____ ft. depth gage No. <u>7</u>		
			10. Screen: Manufacturer's name _____ <u>Doerrs</u> Type <u>steel</u> Dia. <u>1 1/2</u> Slot <u>3/16</u> Length <u>8</u> Set between <u>37</u> ft. and <u>35</u> ft. Gravel pack? <input checked="" type="checkbox"/> Size range of material <u>3/4 3/8</u>		
Top soil			11. Static water level: _____ mo./day/yr. <u>16</u> ft. below land surface Date <u>3-25-77</u>		
Clay			12. Pumping level below land surfaces: <u>27 1/2</u> ft. after <u>1</u> hrs. pumping <u>400</u> g.p.m. _____ ft. after _____ hrs. pumping _____ g.p.m. Estimated maximum yield _____ g.p.m.		
Sand			13. Water sample submitted: _____ mo./day/yr. <input checked="" type="checkbox"/> Yes <input type="checkbox"/> No Date <u>3-25-77</u>		
Gravel			14. Well head completion: <input type="checkbox"/> Pitless adapter _____ inches above grade		
Clay			15. Well grouted? <input checked="" type="checkbox"/> With: <input checked="" type="checkbox"/> Neat cement <input type="checkbox"/> Bentonite <input type="checkbox"/> Concrete Depth: From <u>0</u> ft. to <u>10</u> ft.		
			16. Nearest source of possible contamination: ft. _____ Direction _____ Type _____ Well disinfected upon completion? <u>HTH</u> Yes <input type="checkbox"/> No <input type="checkbox"/>		
			17. Pump: _____ Not installed Manufacturer's name <u>W.L.R.</u> Model number <u>5-100H</u> HP <u>5</u> Volts _____ Length of drop pipe <u>20</u> ft. capacity <u>900</u> g.p.m. Type: <input type="checkbox"/> Submersible <input checked="" type="checkbox"/> Turbine <input type="checkbox"/> Jet <input type="checkbox"/> Reciprocating <input type="checkbox"/> Centrifugal <input type="checkbox"/> Other		
			20. Water well contractor's certification: This well was drilled under my jurisdiction and this report is true to the best of my knowledge and belief. <u>Rosencrantz-Bemis Bemis</u> <u>134</u> Business name License No. Address <u>Great Bend, Kansas</u> <u>67530</u> Signed <u>Andy Kilgore</u> Date <u>1-21-77</u> Authorized representative		
18. Elevation: Topography: <input type="checkbox"/> Hill <input type="checkbox"/> Slope <input checked="" type="checkbox"/> Upland <input type="checkbox"/> Valley			19. Remarks: 		

T 24 S
 R 18 E/W
 Sec 5
 CNE

Forward the white, blue and pink copies to the Department of Health and Environment

Form WWC-5