


1 LOCATION OF WATER WELL: County: Edwards	Fraction SE 1/4 NW 1/4 SE 1/4	Section Number 11	Township Number T 24 S	Range Number R 18W E/W
---	---	-----------------------------	----------------------------------	----------------------------------

Distance and direction from nearest town or city street address of well if located within city?
3 1/4 N of Lewis, Kansas

2 WATER WELL OWNER: Bill Ruth	Red Tiger Drilling	1-11 Ruth
RR#, St. Address, Box #: Lewis, Kansas	1720 Ks. State Bank Bldg.	Board of Agriculture, Division of Water Resources
City, State, ZIP Code: 67552	Wichita, Kansas 67202	Application Number: T83-343

3 LOCATE WELL'S LOCATION WITH AN "X" IN SECTION BOX:

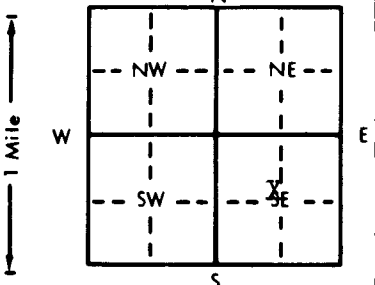

4 DEPTH OF COMPLETED WELL: 65 ft.	ELEVATION: Unknown			
Depth(s) Groundwater Encountered: 25 ft.	ft. 2. ft. 3. ft.			
WELL'S STATIC WATER LEVEL: 25 ft. below land surface	measured on 8/10/83 mo/day/yr			
Pump test data: Well water was ft. after hours pumping gpm				
Est. Yield 60 gpm: Well water was ft. after hours pumping gpm				
Bore Hole Diameter: 8 in. to 6.5 in. and in. to ft.				
WELL WATER TO BE USED AS:				
1 Domestic	3 Feedlot	6 <u>Oil field water supply</u>	9 Dewatering	12 Other (Specify below)
2 Irrigation	4 Industrial	7 Lawn and garden only	10 Observation well	
Was a chemical/bacteriological sample submitted to Department? Yes.....No.....		If yes, mo/day/yr sample was submitted		
Water Well Disinfected? Yes		No		

5 TYPE OF BLANK CASING USED:	5 Wrought iron	8 Concrete tile	CASING JOINTS: <u>Glued</u> Clamped
1 Steel	3 RMP (SR)	6 Asbestos-Cement	9 Other (specify below) Welded
2 <u>PVC</u>	4 ABS	7 Fiberglass Threaded
Blank casing diameter: in. to 4.5 in.	ft., Dia.	ft., Dia.	in. to ft.
Casing height above land surface: in., weight 12 lbs./ft.	Wall thickness or gauge No.	Sch. 40	
TYPE OF SCREEN OR PERFORATION MATERIAL:			
1 Steel	3 Stainless steel	5 Fiberglass	8 RMP (SR)
2 Brass	4 Galvanized steel	6 Concrete tile	9 ABS
SCREEN OR PERFORATION OPENINGS ARE:		5 Gauzed wrapped	8 <u>Saw cut</u> 11 None (open hole)
1 Continuous slot	3 Mill slot	6 Wire wrapped	9 Drilled holes
2 Louvered shutter	4 Key punched	7 <u>Torch cut</u>	10 Other (specify)
SCREEN-PERFORATED INTERVALS:	From 45 ft. to 65 ft.	ft. From ft. to ft.	ft.
GRAVEL PACK INTERVALS:	From 10 ft. to 65 ft.	ft. From ft. to ft.	ft.

6 GROUT MATERIAL:	1 Neat cement	2 Cement grout	3 <u>Bentonite</u>	4 Other
Grout Intervals: From 0 ft. to 10 ft.	ft. From ft. to ft.	ft. From ft. to ft.	ft.	ft.
What is the nearest source of possible contamination:				
1 Septic tank	4 Lateral lines	7 Pit privy	10 Livestock pens	14 Abandoned water well
2 Sewer lines	5 Cess pool	8 Sewage lagoon	11 Fuel storage	15 <u>Oil well/Gas well</u>
3 Watertight sewer lines	6 Seepage pit	9 Feedyard	12 Fertilizer storage	16 Other (specify below)
13 Insecticide storage				
Direction from well? South	How many feet? 60			

FROM	TO	LITHOLOGIC LOG	FROM	TO	LITHOLOGIC LOG
0	20	Clay			
20	65	Sand and Gravel			

7 CONTRACTOR'S OR LANDOWNER'S CERTIFICATION: This water well was (1) constructed, (2) reconstructed, or (3) plugged under my jurisdiction and was completed on (mo/day/year) **8/10/83** and this record is true to the best of my knowledge and belief. Kansas Water Well Contractor's License No. **186**. This Water Well Record was completed on (mo/day/yr) **9/20/83** under the business name of **Kellys Water Well Service** by (signature) *[Signature]*

INSTRUCTIONS: Use typewriter or ball point pen, **PLEASE PRESS FIRMLY** and **PRINT** clearly. Please fill in blanks, underline or circle the correct answers. Send top three copies to Kansas Department of Health and Environment, Division of Environment, Environmental Geology Section, Topeka, KS 66620. Send one to WATER WELL OWNER and retain one for your records.

OFFICE USE ONLY
T
24 R
18
EWD
SEC 1
SE 1/4 NW 1/4 SE 1/4