


1 LOCATION OF WATER WELL: Fraction NW 1/4 NE 1/4 NW 1/4 Section Number 25 Township Number T 24 S Range Number R 18 E/W (W)
 County: Edwards

Distance and direction from nearest town or city street address of well if located within city?
 Approximately 100 Ft East and 140 Ft South of Intersection of First Street & Main, Lewis, KS 01928023 MW-1

2 WATER WELL OWNER: Lewis Cooperative Exchange
 RR#, St. Address, Box #: 100 North Main Board of Agriculture, Division of Water Resources
 City, State, ZIP Code: Lewis, KS 67552 Application Number:

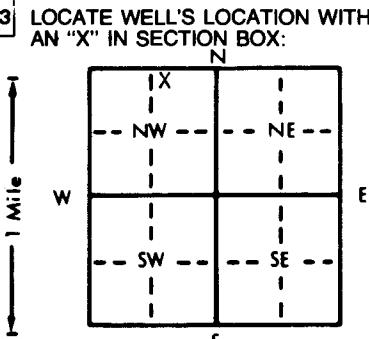

4 DEPTH OF COMPLETED WELL: 52.0 ft. ELEVATION: Approximate Surface Elevation: 2142
 Depth(s) Groundwater Encountered 1. 37.0 ft. 2. ft. 3. ft.
 WELL'S STATIC WATER LEVEL 37.32 ft. below land surface measured on mo/day/yr 07/21/92
 Pump test data: Well water was ft. after hours pumping gpm
 Est. Yield N/A gpm: Well water was ft. after hours pumping gpm
 Bore Hole Diameter 8.5 in. to 52.0 ft., and in. to ft.
 WELL WATER TO BE USED AS:
 5 Public water supply 8 Air conditioning 11 Injection well
 1 Domestic 3 Feedlot 6 Oil field water supply 9 Dewatering 12 Other (Specify below)
 2 Irrigation 4 Industrial 7 Lawn and garden only (10) Monitoring well
 Was a chemical/bacteriological sample submitted to Department? Yes No X; If yes, mo/day/yr sample was submitted
 Water Well Disinfected? Yes No X

5 TYPE OF BLANK CASING USED:
 1 Steel 3 RMP (SR) 5 Wrought iron 8 Concrete tile CASING JOINTS: Glued Clamped
(2) PVC 4 ABS 6 Asbestos-Cement 9 Other (specify below) Welded
 7 Fiberglass Threaded X
 Blank casing diameter 2.0 in. to 27.0 ft., Dia in. to ft., Dia in. to ft.
 Casing height above land surface Approx. 3 in., weight lbs./ft. Wall thickness or gauge No. Schedule 40
 TYPE OF SCREEN OR PERFORATION MATERIAL:
 1 Steel 3 Stainless steel 5 Fiberglass 8 RMP (SR) 10 Asbestos-cement
 2 Brass 4 Galvanized steel 6 Concrete tile 9 ABS 11 Other (specify)
 12 None used (open hole)
 SCREEN OR PERFORATION OPENINGS ARE:
 1 Continuous slot (3) Mill slot 5 Gauzed wrapped 8 Saw cut 11 None (open hole)
 2 Louvered shutter 4 Key punched 6 Wire wrapped 9 Drilled holes
 7 Torch cut 10 Other (specify)
 SCREEN-PERFORATED INTERVALS: From 27.0 ft. to 52.0 ft., From ft. to ft.
 From ft. to ft., From ft. to ft.
 GRAVEL PACK INTERVALS: From 25.0 ft. to 52.0 ft., From ft. to ft.
 From ft. to ft., From ft. to ft.

6 GROUT MATERIAL: (1) Neat cement 2 Cement grout (3) Bentonite 4 Other
 Grout Intervals: From 0.0 ft. to 23.0 ft., From 23.0 ft. to 25.0 ft., From ft. to ft.
 What is the nearest source of possible contamination:
 1 Septic tank 4 Lateral lines 7 Pit privy 10 Livestock pens 14 Abandoned water well
 2 Sewer lines 5 Cess pool 8 Sewage lagoon 11 Fuel storage 15 Oil well/Gas well
 3 Watertight sewer lines 6 Seepage pit 9 Feedyard 12 Fertilizer storage (16) Other (specify below)
 13 Insecticide storage UST excavation
 Direction from well? North How many feet? 5

FROM	TO	LITHOLOGIC LOG	FROM	TO	PLUGGING INTERVALS
0.0	5.5	FIII: Brown Sandy Silt			Flush Mount Well Head Completion as per letters dated 07/17/92 & 08/05/92 by Don Taylor.
5.5	11.0	Fine Sand, Tan-Brown, Silty			
11.0	15.5	Medium Sand With Fat Clay, Dark Brown			
15.5	18.5	Fine to Medium Sand, Brown			
18.5	25.0	Fine Sand, Brown, Silty			
25.0	27.0	Fine to Medium Sand, Tan-Gray			
27.0	27.5	Medium to Coarse Sand, Gray			
27.5	35.0	Fine to Medium Sand, Tan			
35.0	41.5	Medium to Coarse Sand, Tan, Brown			

7 CONTRACTOR'S OR LANDOWNER'S CERTIFICATION: This water well was (1) constructed, (2) reconstructed, or (3) plugged under my jurisdiction and was completed on (mo/day/year) 07/21/92 and this record is true to the best of my knowledge and belief. Kansas Water Well Contractor's License No. 416 This Water Well Record was completed on (mo/day/yr) 07/21/92 under the business name of Terracon Consultants, Inc. by (signature) Steve Fischer

OFFICE USE ONLY

T

R

EW

SEC.

1/4

1/4

1/4