


WATER WELL RECORD Form WWC-5 KSA 82a-1212

1 LOCATION OF WATER WELL: County: Edwards Fraction NW 1/4 NE 1/4 NW 1/4 Section Number 25 Township Number T 24 S Range Number R 18 EW

Distance and direction from nearest town or city street address of well if located within city? Approximately 330 Ft East and 75 Ft South of Intersection of First Street & Main, Lewis, KS 01928023 MW-6

2 WATER WELL OWNER: Lewis Cooperative Exchange RR#, St. Address, Box #: 100 North Main City, State, ZIP Code: Lewis, KS 67552 Board of Agriculture, Division of Water Resources Application Number: Approximate Surface Elevation: 2142

3 LOCATE WELL'S LOCATION WITH AN "X" IN SECTION BOX:

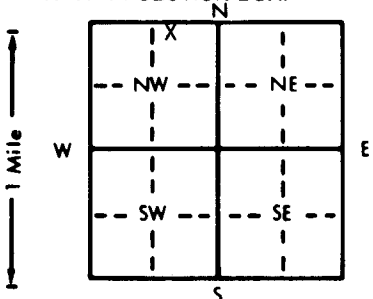

4 DEPTH OF COMPLETED WELL: 52.0 ft. ELEVATION: Approximate Surface Elevation: 2142
 Depth(s) Groundwater Encountered 1. 38.0 ft. 2. ft. 3. ft.
 WELL'S STATIC WATER LEVEL: ft. below land surface measured on mo/day/yr
 Pump test data: Well water was ft. after hours pumping gpm
 Est. Yield N/A gpm: Well water was ft. after hours pumping gpm
 Bore Hole Diameter: 8.5 in. to 52.0 ft., and in. to ft.
 WELL WATER TO BE USED AS: 5 Public water supply 8 Air conditioning 11 Injection well
 1 Domestic 3 Feedlot 6 Oil field water supply 9 Dewatering 12 Other (Specify below)
 2 Irrigation 4 Industrial 7 Lawn and garden only 10 Monitoring well
 Was a chemical/bacteriological sample submitted to Department? Yes No X If yes, mo/day/yr sample was submitted Water Well Disinfected? Yes No X

5 TYPE OF BLANK CASING USED: 1 Steel 2 PVC 3 RMP (SR) 4 ABS 5 Wrought iron 6 Asbestos-Cement 7 Fiberglass 8 Concrete tile 9 Other (specify below) CASING JOINTS: Glued Clamped Welded Threaded X
 Blank casing diameter: 2.0 in. to 27.0 ft., Dia. in. to ft., Dia. in. to ft.
 Casing height above land surface: Approx. 3 in., weight lbs./ft. Wall thickness or gauge No. Schedule 40

TYPE OF SCREEN OR PERFORATION MATERIAL: 1 Steel 2 Brass 3 Stainless steel 4 Galvanized steel 5 Fiberglass 6 Concrete tile 7 PVC 8 RMP (SR) 9 ABS 10 Asbestos-cement 11 Other (specify) 12 None used (open hole)

SCREEN OR PERFORATION OPENINGS ARE: 1 Continuous slot 2 Louvered shutter 3 Mill slot 4 Key punched 5 Gauzed wrapped 6 Wire wrapped 7 Torch cut 8 Saw cut 9 Drilled holes 10 Other (specify) 11 None (open hole)

SCREEN-PERFORATED INTERVALS: From 27.0 ft. to 52.0 ft., From ft. to ft.
 GRAVEL PACK INTERVALS: From 25.0 ft. to 52.0 ft., From ft. to ft.

6 GROUT MATERIAL: 1 Neat cement 2 Cement grout 3 Bentonite 4 Other Grout Intervals: From 0.0 ft. to 23.0 ft., From 23.0 ft. to 25.0 ft., From ft. to ft.

What is the nearest source of possible contamination: 1 Septic tank 2 Sewer lines 3 Watertight sewer lines 4 Lateral lines 5 Cess pool 6 Seepage pit 7 Pit privy 8 Sewage lagoon 9 Feedyard 10 Livestock pens 11 Fuel storage 12 Fertilizer storage 13 Insecticide storage 14 Abandoned water well 15 Oil well/Gas well 16 Other (specify below) UST Excavation
 Direction from well? Southwest How many feet? Approximately 230

FROM	TO	LITHOLOGIC LOG	FROM	TO	PLUGGING INTERVALS
0.0	2.5	Fill: Sandy Fat Clay, Brown			Flush Mount Well Head Completion as per letters dated 07/17/92 & 08/05/92 by Don Taylor.
2.5	11.0	Silty Fat Clay, Olive-Tan			
11.0	13.5	Sandy Fat Clay, Orange-Tan			
13.5	15.0	Fine Sand With Fat Clay, Brown-Red			
15.0	22.5	Fine to Medium Sand, Tan			
22.5	26.0	Medium Sand, Tan-Brown			
26.0	30.0	Fine Sand, Tan			
30.0	39.5	Medium to Coarse Sand, Tan, White, Pink			

7 CONTRACTOR'S OR LANDOWNER'S CERTIFICATION: This water well was (1) constructed, (2) reconstructed, or (3) plugged under my jurisdiction and was completed on (mo/day/year) 7/25/92 and this record is true to the best of my knowledge and belief. Kansas Water Well Contractor's License No. 416 This Water Well Record was completed on (mo/day/yr) 8-25-92 under the business name of Terracon Consultants, Inc. by (signature) Steve Fischer