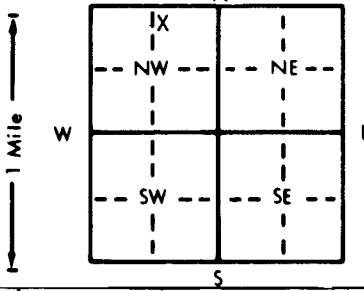


1 LOCATION OF WATER WELL: County: Edwards Fraction NW 1/4 NE 1/4 NW 1/4 Section Number 25 Township Number T 24 S Range Number R 18 EW

Distance and direction from nearest town or city street address of well if located within city?
 Approximately 430 Ft East and 50 Ft South of Intersection of First Street & Main, Lewis, KS 01928023 MW-8

2 WATER WELL OWNER: Lewis Cooperative Exchange
 RR#, St. Address, Box # : 100 North Main Board of Agriculture, Division of Water Resources
 City, State, ZIP Code : Lewis, KS 67552 Application Number:

3 LOCATE WELL'S LOCATION WITH AN "X" IN SECTION BOX:


4 DEPTH OF COMPLETED WELL: 52.0 ft. ELEVATION: Approximate Surface Elevation: 2142
 Depth(s) Groundwater Encountered 1. 37.0 ft. 2. ft. 3. ft.
 WELL'S STATIC WATER LEVEL ft. below land surface measured on mo/day/yr
 Pump test data: Well water was ft. after hours pumping gpm
 Est. Yield N/A gpm: Well water was ft. after hours pumping gpm
 Bore Hole Diameter 8.5 in. to 52.0 ft., and in. to ft.
 WELL WATER TO BE USED AS:
 5 Public water supply 8 Air conditioning 11 Injection well
 1 Domestic 3 Feedlot 6 Oil field water supply 9 Dewatering 12 Other (Specify below)
 2 Irrigation 4 Industrial 7 Lawn and garden only 10 Monitoring well
 Was a chemical/bacteriological sample submitted to Department? Yes No X; If yes, mo/day/yr sample was submitted
 Water Well Disinfected? Yes No X

5 TYPE OF BLANK CASING USED:
 1 Steel 3 RMP (SR) 5 Wrought iron 8 Concrete tile CASING JOINTS: Glued Clamped
 2 PVC 4 ABS 6 Asbestos-Cement 9 Other (specify below) Welded
 7 Fiberglass Threaded X
 Blank casing diameter 2.0 in. to 27.0 ft., Dia in. to ft., Dia in. to ft.
 Casing height above land surface Approx. -3 in., weight lbs./ft. Wall thickness or gauge No. Schedule 40
 TYPE OF SCREEN OR PERFORATION MATERIAL:
 1 Steel 3 Stainless steel 5 Fiberglass 7 PVC 10 Asbestos-cement
 2 Brass 4 Galvanized steel 6 Concrete tile 8 RMP (SR) 11 Other (specify)
 9 ABS 12 None used (open hole)
 SCREEN OR PERFORATION OPENINGS ARE:
 1 Continuous slot 3 Mill slot 5 Gauzed wrapped 8 Saw cut 11 None (open hole)
 2 Louvered shutter 4 Key punched 6 Wire wrapped 9 Drilled holes
 7 Torch cut 10 Other (specify)
 SCREEN-PERFORATED INTERVALS: From 27.0 ft. to 52.0 ft., From ft. to ft.
 From ft. to ft., From ft. to ft.
 GRAVEL PACK INTERVALS: From 25.0 ft. to 52.0 ft., From ft. to ft.
 From ft. to ft., From ft. to ft.

6 GROUT MATERIAL: 1 Neat cement 2 Cement grout 3 Bentonite 4 Other
 Grout Intervals: From 0.0 ft. to 23.0 ft., From 23.0 ft. to 25.0 ft., From ft. to ft.
 What is the nearest source of possible contamination:
 1 Septic tank 4 Lateral lines 7 Pit privy 10 Livestock pens 14 Abandoned water well
 2 Sewer lines 5 Cess pool 8 Sewage lagoon 11 Fuel storage 15 Oil well/Gas well
 3 Watertight sewer lines 6 Seepage pit 9 Feedyard 12 Fertilizer storage 16 Other (specify below)
 13 Insecticide storage 14 Excavation
 Direction from well? Southwest How many feet? Approximately 330

| FROM | TO | LITHOLOGIC LOG | FROM | TO | PLUGGING INTERVALS |
|------|------|---------------------------------------|------|----|--|
| 0.0 | 3.5 | Fill: Sandy Fat Clay, Black | | | Flush Mount Well Head Completion as per letters dated 07/17/92 & 08/05/92 by Don Taylor. |
| 3.5 | 4.5 | Sandy Fat Clay, Brown-Red | | | |
| 4.5 | 12.5 | Silty Fat Clay, Olive-Brown | | | |
| 12.5 | 16.0 | Sandy Fat Clay, Red-Brown | | | |
| 16.0 | 30.0 | Fine Sand, Brown | | | |
| 30.0 | 34.5 | Fine to Coarse Sand, Tan-Brown, White | | | |
| 34.5 | 39.5 | Medium to Coarse Sand, Tan-Gray | | | |

7 CONTRACTOR'S OR LANDOWNER'S CERTIFICATION: This water well was (1) constructed, (2) reconstructed, or (3) plugged under my jurisdiction and was completed on (mo/day/year) 7/25/92 and this record is true to the best of my knowledge and belief. Kansas Water Well Contractor's License No. 416 This Water Well Record was completed on (mo/day/year) 8-25-92 under the business name of Terracon Consultants, Inc. by (signature) Steve Fischer