


1 LOCATION OF WATER WELL: County: Edwards Fraction: NW 1/4 NE 1/4 NW 1/4 Section Number: 25 Township Number: T 24 S Range Number: R 18 EW

Distance and direction from nearest town or city street address of well if located within city?
 Approximately 370 Ft East and 30 Ft North of Intersection of First Street & Main, Lewis, KS 01928023 MW-9

2 WATER WELL OWNER: Lewis Cooperative Exchange
 RR#, St. Address, Box #: 100 North Main Board of Agriculture, Division of Water Resources
 City, State, ZIP Code: Lewis, KS 67552 Application Number:

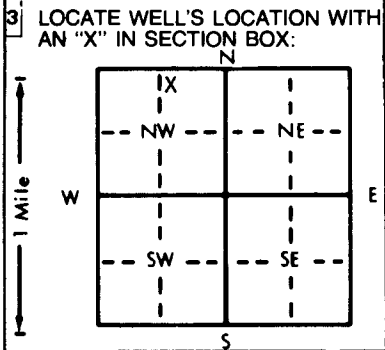

4 DEPTH OF COMPLETED WELL: 52.0 ft. ELEVATION: Approximate Surface Elevation: 2142
 Depth(s) Groundwater Encountered: 1. 37.0 ft. 2. ft. 3. ft.
 WELL'S STATIC WATER LEVEL: 38.71 ft. below land surface measured on mo/day/yr: 07/25/92
 Pump test data: Well water was ft. after hours pumping gpm
 Est. Yield: N/A gpm: Well water was ft. after hours pumping gpm
 Bore Hole Diameter: 8.5 in. to 52.0 ft., and in. to ft.
 WELL WATER TO BE USED AS:
 5 Public water supply 8 Air conditioning 11 Injection well
 1 Domestic 3 Feedlot 6 Oil field water supply 9 Dewatering 12 Other (Specify below)
 2 Irrigation 4 Industrial 7 Lawn and garden only 10 Monitoring well
 Was a chemical/bacteriological sample submitted to Department? Yes No X If yes, mo/day/yr sample was submitted
 Water Well Disinfected? Yes No X

5 TYPE OF BLANK CASING USED:
 1 Steel 3 RMP (SR) 5 Wrought iron 8 Concrete tile CASING JOINTS: Glued Clamped
 2 PVC 4 ABS 6 Asbestos-Cement 9 Other (specify below) Welded
 7 Fiberglass Threaded X
 Blank casing diameter: 2.0 in. to 27.0 ft., Dia. in. to ft., Dia. in. to ft.
 Casing height above land surface: Approx. 3 in., weight lbs./ft. Wall thickness or gauge No. Schedule 40
 TYPE OF SCREEN OR PERFORATION MATERIAL:
 1 Steel 3 Stainless steel 5 Fiberglass 7 PVC 10 Asbestos-cement
 2 Brass 4 Galvanized steel 6 Concrete tile 8 RMP (SR) 11 Other (specify)
 9 ABS 12 None used (open hole)
 SCREEN OR PERFORATION OPENINGS ARE:
 1 Continuous slot 3 Mill slot 5 Gauzed wrapped 8 Saw cut 11 None (open hole)
 2 Louvered shutter 4 Key punched 6 Wire wrapped 9 Drilled holes
 7 Torch cut 10 Other (specify)
 SCREEN-PERFORATED INTERVALS: From 27.0 ft. to 52.0 ft., From ft. to ft.
 GRAVEL PACK INTERVALS: From 25.0 ft. to 52.0 ft., From ft. to ft.

6 GROUT MATERIAL: 1 Neat cement 2 Cement grout 3 Bentonite 4 Other
 Grout Intervals: From 0.0 ft. to 23.0 ft., From 23.0 ft. to 25.0 ft., From ft. to ft.
 What is the nearest source of possible contamination:
 1 Septic tank 4 Lateral lines 7 Pit privy 10 Livestock pens 14 Abandoned water well
 2 Sewer lines 5 Cess pool 8 Sewage lagoon 11 Fuel storage 15 Oil well/Gas well
 3 Watertight sewer lines 6 Seepage pit 9 Feedyard 12 Fertilizer storage 16 Other (specify below)
 13 Insecticide storage UST Excavation
 Direction from well? Northeast How many feet? Approximately 300

FROM	TO	LITHOLOGIC LOG	FROM	TO	PLUGGING INTERVALS
0.0	10.5	Silty Fat Clay, Brown			Flush Mount Well Head Completion as per letters dated 07/17/92 & 08/05/92 by Don Taylor.
10.5	12.0	Silty - Sandy Fat Clay, Olive			
12.0	18.5	Fine to Medium Sand, Brown			
18.5	30.0	Fine Sand, Brown-Tan			
30.0	36.0	Medium to Coarse Sand, White, Tan, Pink			
36.0	37.5	Silty Fat Clay, Olive			

7 CONTRACTOR'S OR LANDOWNER'S CERTIFICATION: This water well was (1) constructed, (2) reconstructed, or (3) plugged under my jurisdiction and was completed on (mo/day/year) 07/25/92 and this record is true to the best of my knowledge and belief. Kansas Water Well Contractor's License No. 416 This Water Well Record was completed on (mo/day/yr) 8/25/92 under the business name of Terracon Consultants, Inc. by (signature) Steve Fischer