


1 LOCATION OF WATER WELL: County: **EDWARDS** Fraction: **NW 1/4 NE 1/4 NW 1/4** Section Number: **25** Township Number: **T 24 S** Range Number: **R 18 W**

Distance and direction from nearest town or city street address of well if located within city? **MW-13**

2 WATER WELL OWNER: **Lewis Coop**
 RR#, St. Address, Box #: **Lewis, Kansas**
 City, State, ZIP Code: **Lewis, Kansas**
 Board of Agriculture, Division of Water Resources
 Application Number:

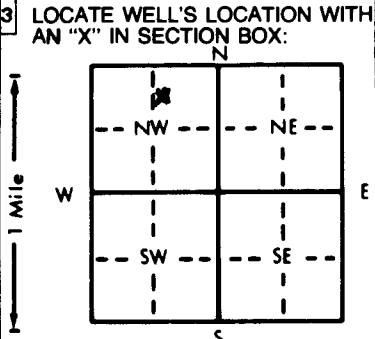


4 DEPTH OF COMPLETED WELL: **55** ft. ELEVATION:
 Depth(s) Groundwater Encountered 1. **38** ft. 2. ft. 3. ft.
 WELL'S STATIC WATER LEVEL: **38** ft. below land surface measured on **10-19-93** mo/day/yr
 Pump test data: Well water was ft. after hours pumping gpm
 Est. Yield gpm Well water was ft. after hours pumping gpm
 Bore Hole Diameter: **8** in. to **55** ft., and in. to ft.
 WELL WATER TO BE USED AS:
 5 Public water supply 8 Air conditioning 11 Injection well
 1 Domestic 3 Feedlot 6 Oil field water supply 9 Dewatering 12 Other (Specify below)
 2 Irrigation 4 Industrial 7 Lawn and garden only 10 Monitoring well
 Was a chemical/bacteriological sample submitted to Department? Yes.....No.....
 If yes, mo/day/yr sample was submitted
 Water Well Disinfected? Yes No **X**

5 TYPE OF BLANK CASING USED:
 1 Steel 3 RMP (SR) 5 Wrought iron 8 Concrete tile CASING JOINTS: Glued Clamped
 2 PVC 4 ABS 6 Asbestos-Cement 9 Other (specify below) Welded **X**
 7 Fiberglass Threaded **X**
 Blank casing diameter: **2** in. to **30** ft., Dia. in. to ft., Dia. in. to ft.
 Casing height above land surface: **0** in., weight: **.69** lbs./ft. Wall thickness or gauge No.
 TYPE OF SCREEN OR PERFORATION MATERIAL:
 1 Steel 3 Stainless steel 5 Fiberglass 8 RMP (SR) 10 Asbestos-cement
 2 Brass 4 Galvanized steel 6 Concrete tile 9 ABS 11 Other (specify)
 12 None used (open hole)
 SCREEN OR PERFORATION OPENINGS ARE:
 1 Continuous slot 3 Mill slot 5 Gauzed wrapped 8 Saw cut 11 None (open hole)
 2 Louvered shutter 4 Key punched 6 Wire wrapped 9 Drilled holes
 7 Torch cut 10 Other (specify)
 SCREEN-PERFORATED INTERVALS: From **30** ft. to **55** ft., From ft. to ft.
 From ft. to ft., From ft. to ft.
 GRAVEL PACK INTERVALS: From **27.5** ft. to **55** ft., From ft. to ft.
 From ft. to ft., From ft. to ft.

6 GROUT MATERIAL: 1 Neat cement 2 Cement grout 3 Bentonite 4 Other
 Grout intervals: From **0** ft. to **25** ft., From **25** ft. to **27.5** ft., From ft. to ft.
 What is the nearest source of possible contamination:
 1 Septic tank 4 Lateral lines 7 Pit privy 10 Livestock pens 14 Abandoned water well
 2 Sewer lines 5 Cess pool 8 Sewage lagoon 11 Fuel storage 15 Oil well/Gas well
 3 Watertight sewer lines 6 Seepage pit 9 Feedyard 12 Fertilizer storage 16 Other (specify below)
 13 Insecticide storage
 Direction from well? **NA** How many feet?

FROM	TO	LITHOLOGIC LOG	FROM	TO	PLUGGING INTERVALS
0	1.5	Concrete			
1.5	3.5	Sand - fine grain			
3.5	9	Silty clay			
9	12	Sand			
12	16.5	Clay			
16.5	49	Sand			
49	55	Silty sandy clay			

7 CONTRACTOR'S OR LANDOWNER'S CERTIFICATION: This water well was **(1)** constructed, (2) reconstructed or (3) plugged under my jurisdiction and was completed on (mo/day/year) **10-23-93** and this record is true to the best of my knowledge and belief. Kansas Water Well Contractor's License No. **102** This Water Well Record was completed on (mo/day/year) **10-19-93** under the business name of **Layne, Inc** by (signature) **Steven R. Mitchell**

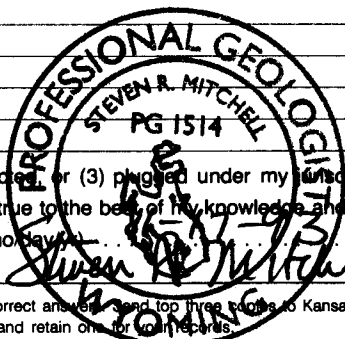

OFFICE USE ONLY
T
R
EW
SEC.