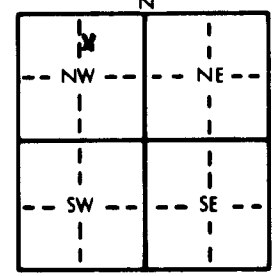


1 LOCATION OF WATER WELL: County: Edwards Fraction: NW 1/4 NE 1/4 NW 1/4 Section Number: 25 Township Number: T 24 S Range Number: R 18 NW

Distance and direction from nearest town or city street address of well if located within city? OW-4

2 WATER WELL OWNER: Lewis Coop RR#, St. Address, Box #: LEWIS, KANSAS Board of Agriculture, Division of Water Resources Application Number:

3 LOCATE WELL'S LOCATION WITH AN "X" IN SECTION BOX:  4 DEPTH OF COMPLETED WELL: 50 ft. ELEVATION: 38 ft. below land surface measured on mo/day/yr





Bore Hole Diameter: 7 in. to 50 ft., and 50 in. to 50 ft.

WELL WATER TO BE USED AS:

5 Public water supply	8 Air conditioning	11 Injection well
1 Domestic	3 Feedlot	6 Oil field water supply
2 Irrigation	4 Industrial	7 Lawn and garden only
		10 Monitoring well

Was a chemical/bacteriological sample submitted to Department? Yes X No X; If yes, mo/day/yr sample was submitted

Water Well Disinfected? Yes X No X

5 TYPE OF BLANK CASING USED:

1 Steel	3 RMP (SR)	6 Asbestos-Cement	9 Other (specify below)
2 PVC	4 ABS	7 Fiberglass	

CASING JOINTS: Glued X Clamped X Welded X Threaded X


Casing height above land surface: 0 in., weight 69 lbs./ft. Wall thickness or gauge No. 7

TYPE OF SCREEN OR PERFORATION MATERIAL:

1 Steel	3 Stainless steel	5 Fiberglass	8 RMP (SR)	11 Other (specify)
2 Brass	4 Galvanized steel	6 Concrete tile	9 ABS	12 None used (open hole)

SCREEN OR PERFORATION OPENINGS ARE:

1 Continuous slot	3 Mill slot	5 Gauzed wrapped	8 Saw cut	11 None (open hole)
2 Louvered shutter	4 Key punched	6 Wire wrapped	9 Drilled holes	
		7 Torch cut	10 Other (specify)	



6 GROUT MATERIAL: 0 Neat cement 20 Cement grout 20 Bentonite 22.5 Other

Grout Intervals: From 0 ft. to 20 ft., From 20 ft. to 22.5 ft., From 22.5 ft. to 22.5 ft.


What is the nearest source of possible contamination:

1 Septic tank	4 Lateral lines	7 Pit privy	10 Livestock pens	14 Abandoned water well
2 Sewer lines	5 Cess pool	8 Sewage lagoon	11 Fuel storage	15 Oil well/Gas well
3 Watertight sewer lines	6 Seepage pit	9 Feedyard	12 Fertilizer storage	16 Other (specify below)
			13 Insecticide storage	

Direction from well? NA How many feet?

FROM	TO	LITHOLOGIC LOG	FROM	TO	PLUGGING INTERVALS
<u>0</u>	<u>50</u>	<u>Concrete</u>			
<u>.5</u>	<u>50</u>	<u>Sandy silty clay</u>			
		<u>w/ sand lenses</u>			

7 CONTRACTOR'S OR LANDOWNER'S CERTIFICATION: This water well was (1) constructed, (2) reconstructed, or (3) plugged under my jurisdiction and was completed on (mo/day/year) 10-23-93 and this record is true to the best of my knowledge and belief. Kansas Water Well Contractor's License No. 102 This Water Well Record was completed on (mo/day/year) 10-23-93 under the business name of Layne, Inc by (signature) Steven R. Mitchell

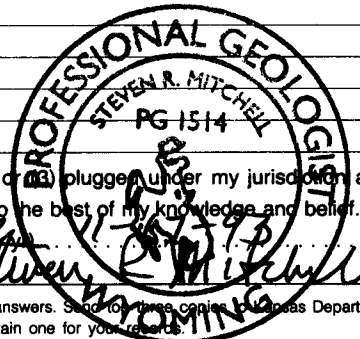

OFFICE USE ONLY
T
R
EW
SEC.