


1 LOCATION OF WATER WELL: County: Edwards Fraction: NW 1/4 NE 1/4 NW 1/4 Section Number: 25 Township Number: T 24 S Range Number: R 18 W

Distance and direction from nearest town or city street address of well if located within city? 0W-1

2 WATER WELL OWNER: Lewis Coop Board of Agriculture, Division of Water Resources
RR#, St. Address, Box #: Lewis, Kansas Application Number:

3 LOCATE WELL'S LOCATION WITH AN "X" IN SECTION BOX:

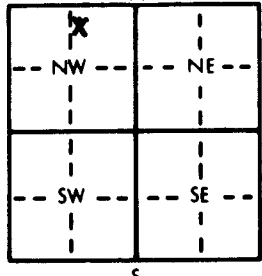

4 DEPTH OF COMPLETED WELL: 60 ft. ELEVATION: 38 ft.

Depth(s) Groundwater Encountered: 38 ft. 2. 38 ft. 3. 38 ft.
WELL'S STATIC WATER LEVEL: 38 ft. below land surface measured on mo/day/yr
Pump test data: Well water was _____ ft. after _____ hours pumping _____ gpm
Est. Yield _____ gpm; Well water was _____ ft. after _____ hours pumping _____ gpm
Bore Hole Diameter: 8 in. to 60 ft., and _____ in. to _____ ft.
WELL WATER TO BE USED AS:
1 Domestic 2 Irrigation 3 Feedlot 4 Industrial 5 Public water supply 6 Oil field water supply 7 Lawn and garden only 8 Air conditioning 9 Dewatering 10 Monitoring well 11 Injection well 12 Other (Specify below)
Was a chemical/bacteriological sample submitted to Department? Yes _____ No _____ If yes, mo/day/yr sample was submitted _____
Water Well Disinfected? Yes _____ No X

5 TYPE OF BLANK CASING USED:
1 Steel 2 PVC 3 RMP (SR) 4 ABS 5 Wrought iron 6 Asbestos-Cement 7 Fiberglass 8 Concrete tile 9 Other (specify below) CASING JOINTS: Glued _____ Clamped _____ Welded _____ Threaded _____ X

Blank casing diameter: 2 in. to 35 ft. Dia. _____ in. to _____ ft. Dia. _____ in. to _____ ft.
Casing height above land surface: 0 in., weight _____ lbs./ft. Wall thickness or gauge No. _____

TYPE OF SCREEN OR PERFORATION MATERIAL:
1 Steel 2 Brass 3 Stainless steel 4 Galvanized steel 5 Fiberglass 6 Concrete tile 7 PVC 8 RMP (SR) 9 ABS 10 Asbestos-cement 11 Other (specify) _____ 12 None used (open hole)

SCREEN OR PERFORATION OPENINGS ARE:
1 Continuous slot 2 Louvered shutter 3 Mill slot 4 Key punched 5 Gauzed wrapped 6 Wire wrapped 7 Torch cut 8 Saw cut 9 Drilled holes 10 Other (specify) _____ 11 None (open hole)

SCREEN-PERFORATED INTERVALS: From 35 ft. to 60 ft., From _____ ft. to _____ ft., From _____ ft. to _____ ft.


GRAVEL PACK INTERVALS: From 32 ft. to 60 ft., From _____ ft. to _____ ft., From _____ ft. to _____ ft.

6 GROUT MATERIAL: 1 Neat cement 2 Cement grout 3 Bentonite 4 Other _____
Grout intervals: From 0 ft. to 30 ft., From 30 ft. to 32 ft., From _____ ft. to _____ ft.

What is the nearest source of possible contamination:
1 Septic tank 2 Sewer lines 3 Watertight sewer lines 4 Lateral lines 5 Cess pool 6 Seepage pit 7 Pit privy 8 Sewage lagoon 9 Feedyard 10 Livestock pens 11 Fuel storage 12 Fertilizer storage 13 Insecticide storage 14 Abandoned water well 15 Oil well/Gas well 16 Other (specify below) _____

Direction from well? NA How many feet? _____

FROM	TO	LITHOLOGIC LOG	FROM	TO	PLUGGING INTERVALS
<u>0</u>	<u>60</u>	<u>Concrete silty sandy clay w/ sand lenses</u>			
<u>0</u>	<u>15</u>				

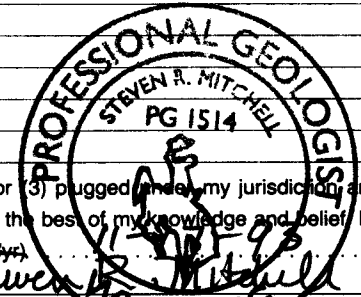

7 CONTRACTOR'S OR LANDOWNER'S CERTIFICATION: This water well was (1) constructed, (2) reconstructed, or (3) plugged under my jurisdiction and was completed on (mo/day/year) 10-23-93 and this record is true to the best of my knowledge and belief. Kansas Water Well Contractor's License No. 102 This Water Well Record was completed on (mo/day/year) _____ under the business name of Layne, Inc by (signature) Steven R. Mitchell