USE TYPEWRITER OR BALL POINT PEN-PRESS FIRMLY, PRINT CLEARLY.

| | | | | | | | | | | |
|---|---|---|---|---|---|---|---|---|---|---|
| | | | | | | | | | | |

T R EW sec 1/4 1/4 1/4 No.

WATER WELL RECORD
KSA 82a-1201-1215

Kansas State Dept. Of Health
(Water Well Contractors)
Forbes-Bldg. 740
Topeka, Kansas 66620

| 1 Location of well: | County | Township name | Fraction | Section number | Town number | Range number |
|---|---|---|---|---|---|---|
| | Edwards | Wayne | SW of NW of SE | 27 | T24S | R18W |

Distance and direction from nearest town or city: 1½ mi. West of Lewis, Kansas
Street address of well location if in city:

3 Owner of well: ~~XXXXXXXXXXXXXX~~ Mrs. Thoran D. Gatterman
Address: Lewis, Kansas

Locate with "X" in section below: Sketch map:

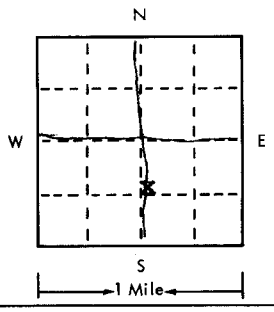


4 Well depth: ~~XX~~ 71 ft. Date of completion 7-2-75
Well diameter 24 in.

5 ☐ Cable tool ☐ Rotary ☐ Driven ☐ Dug
☐ Hollow rod ☐ Jetted ☐ Bored ☒ Reverse rotary

6 Use: ☐ Domestic ☐ Public supply ☐ Industry
☒ Irrigation ☐ Air conditioning ☐ Commercial
☐ Test well ☐ _____

7 Casing: Material Steel Height: above/below
Threaded ☐ Welded ☒ Surface 12 in.
Diam. Weight 30.3 lbs./ft.
16 in. to 35 ft. depth Drive shoe? ☐ Yes ☒ No
___ in. to ___ ft. depth

| 2 Type and color of material | From | To |
|---|---|---|
| Top soil & sand | 0 | 15 |
| Sandy clay | 15 | 24 |
| Sand & gravel | 24 | 44 |
| Yellow clay & limestone | 44 | 47 |
| Sand & gravel | 47 | 70 XXX |
| Brown clay | 70 | 71 |
| | | |
| | | |
| | | |
| | | |
| | | |
| | | |
| | | |
| | | |
| | | |
| (use a second sheet if needed) | | |

8 Screen:
Manufacturer Doerr
Type Double-slot Dia. 16"
Slot gauze 1/8 Length 36'
Set between 35 ft. and 71 ft.
Fittings:
Gravel pack ☒ Yes ☐ No Size range of material 3/8-200

9 Static water level:
24 ft. below land surface Date 7-2-75

10 Pumping level below land surfaces: N/C
___ ft. after ___ hrs. pumping ___ g.p.m.
___ ft. after ___ hrs. pumping ___ g.p.m.
Estimated maximum yield ___ g.p.m.

11 Water sample submitted:
☐ Yes ☒ No Date ___

12 Well head completion:
☐ Pitless adapter 12 ☐ Inches above grade

13 Well grouted? ☒ Yes = ☐ No
☒ Neat cement ☐ Bentonite ☐ _____
Depth: From 0 ft. to 10 ft.

14 Nearest source of possible contamination: NONE KNOWN
ft. ___ Direction ___ Type ___
Well disinfected upon completion? ☐ Yes ☒ No

15 Pump: ☒ Not installed
Manufacturer's name ___
Model number ___ HP ___ Volts ___
Length of drop pipe ___ ft. capacity ___ g.m.p.
Type:
☐ Submersible ☐ Turbine
☐ Jet ☐ Reciprocating
☐ Certrifugal ☐ Other

16 Remarks: elevation

Topography:
☐ Hill
☐ Slope
☐ Upland
☐ Valley

17 Water well contractor's certification:
This well was drilled under my jurisdiction and this report is true to the best of my knowledge and belief.
Clarke Well & Eq., Inc. 185
Business name License No.
Address Great Bend, KS
Signed D. W. Clarke Date 7-2-75
Authorized representative

T24S-R18W-27 SW1/4 NW1/4 SE1/4

Forward the white, blue and pink copies to the Kansas State Dept. Of Health.

Form WWC-5

677-H