


WATER WELL RECORD Form WWC-5 KSA 82a-1212

1 LOCATION OF WATER WELL: Fraction : Section Number : Township Number : Range Number  
 COUNTY: 024 EDWARDS : SE 1/4 SW 1/4 SE 1/4 : 34 : T 24 S : R 18 N

Distance and direction from nearest town or city street address of well if located within city?  
 1 W. 1 S. OF LEWIS, KS

2 WATER WELL OWNER: DAVID MCCLAREN 188  
 RR#, St. Address, Box #: R.R. 32, BOX 55 Board of Agriculture, Division of Water Resources  
 City, State, ZIP code : LEWIS, KS 67552- Application Number:

3 LOCATE WELL'S LOCATION WITH AN "X" IN SECTION BOX:

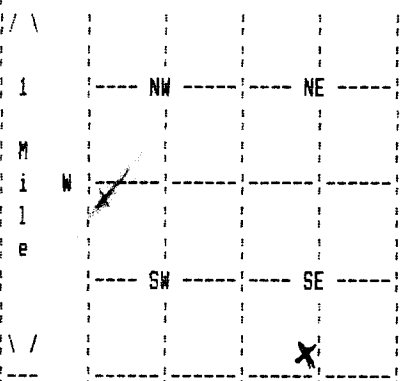

4 DEPTH OF COMPLETED WELL 120 ELEVATION:  
 Depth(s) Groundwater Encountered 1. 55 ft. 2. ft. 3. ft.  
 WELL'S STATIC WATER LEVEL 55 ft. below land surface measured on mo/day/yr  
 Pump testdata: Well water was ft. after hours pumping gpm  
 Estimated Yield gpm: Well water was ft. after hours pumping gpm  
 Bore Hole Diameter 8.75 in. to 120 ft., and in. to ft.  
 WELL WATER TO BE USED AS: 01 DOMESTIC  
 Was a chemical/bacteriological sample submitted to department? No ;  
 If yes, mo/day/yr sample was submitted Water well disinfected? Yes

5 TYPE OF BLANK CASING USED: 02 PVC CASING JOINTS: GLUED  
 Blank casing diameter 5 in. to 110 ft., Dia in. to ft., Dia in. to ft.  
 Casing height above land surface 12 in., weight lbs/ft. Wall thickness or gauge No. 26  
 TYPE OF SCREEN OR PERFORATION MATERIAL: 07 PVC  
 SCREEN OR PERFORATION OPENINGS ARE: 08 SAW CUT

SCREEN PERFORATED INTERVALS: From 110 ft. to 120 ft., From ft. to ft.  
 GRAVEL PACK INTERVALS: From 25 ft. to 120 ft., From ft. to ft.  
 From ft. to ft., From ft. to ft.

6 GROUT MATERIAL 03 BENTONITE  
 Grout Intervals: From 1 ft. to 25 ft., From ft. to ft., From ft. to ft.  
 What is the nearest source of possible contamination: CATTLE PASTURE  
 Direction from well? ALL How many feet? 3

FROM	TO	LITHOLOGIC LOG	FROM	TO	PLUGGING INTERVALS
	2	SILT & SAND			
2	36	TAN CLAY			
36	88	05 SAND AND 17 GRAVEL			
88	109	TAN CLAY			
109	120	05 SAND AND 17 GRAVEL			

7 CONTRACTOR'S OR LANDOWNER'S CERTIFICATION: This water well was Constructed under my jurisdiction and was completed on (mo/day/year) 11/16/92 and this record is true to the best of my knowledge and belief. Kansas Water Well Contractor's License No. 224 This Water Well Record was completed on (mo/day/yr) 12/14/92 under the business name of CARL HAYSE WATER WELL SVC by (signature) Carl Hayse