

CORRECTION TO WATER WELL RECORD (WWC-5)

The following correction(s) was made to the attached WWC-5 log, in order to file the item or to rectify lacking or incorrect information.

Fraction (1/4 1/4 1/4) Section-Township-Range changed:

listed as NW NW NE, 35-245-17-18W

changed to NW NW NE, 35-245-18W

Other changes: Initial statements: _____

Changed to: _____

Comments: _____

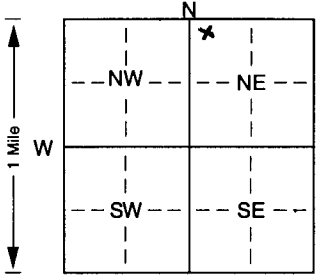
verification method: Written & legal descriptions, position on plat map, and
Lewis 1:24,000 topo. map (buildings shown on map) initials: DRD date: 5/20/2002

submitted by: Kansas Geological Survey, Data Resources Library, 1930 Constant Ave., Lawrence, KS 66047-3726
to: Kansas Dept of Health & Environment Bureau of Water Industrial Programs, Bldg 283, Forbes Field, KS 66620

1] LOCATION OF WATER WELL: Fraction NW 1/4 NW 1/4 NE 1/4 Section Number 35 Township Number T 24 S Range Number R 17-18 EW
 County: Edwards

Distance and direction from nearest town or city street address of well if located within city?
From Lewis, Ks, 1/2 mile West

2] WATER WELL OWNER: Farold Fox
 RR#, St. Address, Box #: Rt. 2 Box 59
 City, State, ZIP Code: Lewis, Ks. 67552
 Board of Agriculture, Division of Water Resources
 Application Number:

3] LOCATE WELL'S LOCATION WITH AN "X" IN SECTION BOX:

 4] DEPTH OF COMPLETED WELL: 70 ft. ELEVATION:
 Depth(s) Groundwater Encountered 1. 1 ft. 2. 1 ft. 3. 1 ft.
 WELL'S STATIC WATER LEVEL: 44 ft. below land surface measured on mo/day/yr 08/07/01
 Pump test data: Well water was 1 ft. after 1 hours pumping 1 gpm
 Est. Yield 1 gpm: Well water was 1 ft. after 1 hours pumping 1 gpm
 Bore Hole Diameter: 9 in. to 1 ft., and 1 in. to 1 ft.
 WELL WATER TO BE USED AS: 5 Public water supply 8 Air conditioning 11 Injection well
 1 Domestic 3 Feedlot 6 Oil field water supply 9 Dewatering 12 Other (Specify below)
 2 Irrigation 4 Industrial 7 Domestic (lawn & garden) 10 Monitoring well
 Was a chemical/bacteriological sample submitted to Department? Yes. X No. X; If yes, mo/day/yr sample was submitted
 Water Well Disinfected? Yes X No X

5] TYPE OF BLANK CASING USED:
 1 Steel 3 RMP (SR) 5 Wrought iron 8 Concrete tile CASING JOINTS: Glued Clamped
 2 PVC 4 ABS 6 Asbestos-Cement 9 Other (specify below) Welded
 7 Fiberglass Threaded
 Blank casing diameter 5 in. to 30 ft., Dia. 1 in. to 1 ft., Dia. 1 in. to 1 ft.
 Casing height above land surface 24 in., weight 160 lbs./ft. Wall thickness or gauge No. 214
 TYPE OF SCREEN OR PERFORATION MATERIAL:
 1 Steel 3 Stainless steel 5 Fiberglass 7 PVC 10 Asbestos-cement
 2 Brass 4 Galvanized steel 6 Concrete tile 8 RMP (SR) 11 Other (specify)
 9 ABS 12 None used (open hole)
 SCREEN OR PERFORATION OPENINGS ARE:
 1 Continuous slot 3 Mill slot 5 Gauzed wrapped 8 Saw cut 11 None (open hole)
 2 Louvered shutter 4 Key punched 6 Wire wrapped 9 Drilled holes
 7 Torch cut 10 Other (specify) 1 ft.
 SCREEN-PERFORATED INTERVALS: From 30 ft. to 70 ft., From 1 ft. to 1 ft.
 From 1 ft. to 1 ft., From 1 ft. to 1 ft.
 GRAVEL PACK INTERVALS: From 70 ft. to 20 ft., From 1 ft. to 1 ft.
 From 1 ft. to 1 ft., From 1 ft. to 1 ft.

6] GROUT MATERIAL: 1 Neat cement 2 Cement grout 3 Bentonite 4 Other HOLE PLUG
 Grout Intervals: From 20 ft. to 3 ft., From 1 ft. to 1 ft., From 1 ft. to 1 ft.
 What is the nearest source of possible contamination:
 1 Septic tank 4 Lateral lines 7 Pit privy 10 Livestock pens 14 Abandoned water well
 2 Sewer lines 5 Cess pool 8 Sewage lagoon 11 Fuel storage 15 Oil well/Gas well
 3 Watertight sewer lines 6 Seepage pit 9 Feedyard 12 Fertilizer storage 16 Other (specify below)
 13 Insecticide storage WATER WELL
 Direction from well? South How many feet? 10

FROM	TO	LITHOLOGIC LOG	FROM	TO	PLUGGING INTERVALS
<u>0</u>	<u>3</u>	<u>Top Soil</u>			
<u>3</u>	<u>12</u>	<u>Grey Clay tight</u>			
<u>12</u>	<u>23</u>	<u>tan Clay + Fine Sand mix</u>			
<u>23</u>	<u>47</u>	<u>Fine to Small Sand</u>			
<u>47</u>	<u>57</u>	<u>Fine Sand</u>			
<u>57</u>	<u>70</u>	<u>Small Sand</u>			

7] CONTRACTOR'S OR LANDOWNER'S CERTIFICATION: This water well was (1) constructed, (2) reconstructed, or (3) plugged under my jurisdiction and was completed on (mo/day/year) 08/07/01 and this record is true to the best of my knowledge and belief. Kansas Water Well Contractor's Licence No. 134 This Water Well Record was completed on (mo/day/yr) 08/09/01 under the business name of Rosencrutz Bemis Ent. by (signature) Terese Ordoez