


WATER WELL RECORD Form WWC-5 KSA 82a-1212

1 LOCATION OF WATER WELL: Fraction Section Number Township Number Range Number  
 COUNTY: EDWARDS SW 1/4 SW 1/4 NW 1/4 20 T 24 S R 18 W

Distance and direction from nearest town or city street address of well if located within city?  
 3 MILES WEST, 1 MILE NORTH, 1 MILE WEST OF LEWIS

2 WATER WELL OWNER: CROSS BROTHERS Board of Agriculture, Division of Water Resources  
 RR#, St. Address, Box #: ROUTE 1 BOX 52  
 City, State, ZIP code: LEWIS, KS 67552- Application Number:

3 LOCATE WELL'S LOCATION WITH AN "X" IN SECTION BOX:

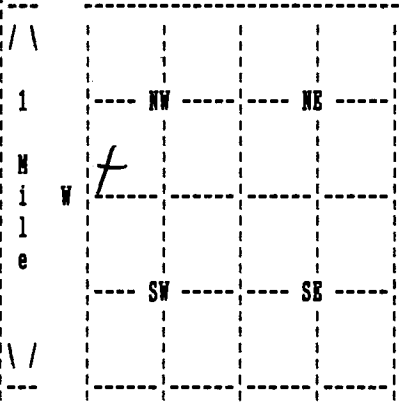

4 DEPTH OF COMPLETED WELL 70 ELEVATION: 0  
 Depth(s) Groundwater Encountered 1. 0 ft. 2. 0 ft. 3. 0 ft.

WELL'S STATIC WATER LEVEL 23 ft. below land surface measured on mo/day/yr 08/12/03  
 Pump testdata: Well water was 0 ft. after 0 hours pumping 0 gpm

Estimated Yield 0 gpm: Well water was 0 ft. after 0 hours pumping 0 gpm

Bore Hole Diameter 8.75 in. to 70 ft., and in. to 0 ft.

WELL WATER TO BE USED AS: LIVESTOCK

Was a chemical/bacteriological sample submitted to department? No ;  
 If yes, mo/day/yr sample was submitted Water well disinfected? Yes

5 TYPE OF BLANK CASING USED: PVC CASING JOINTS: GLUED  
 Blank casing diameter 5 in. to 60 ft., Dia in. to 0 ft., Dia in. to 0 ft.  
 Casing height above land surface 12 in., weight 0 lbs/ft. Wall thickness or gauge No. 26  
 TYPE OF SCREEN OR PERFORATION MATERIAL: PVC  
 SCREEN OR PERFORATION OPENINGS ARE: SAW CUT

SCREEN PERFORATED INTERVALS: From 60 ft. to 70 ft., From 0 ft. to 0 ft.  
 From 0 ft. to 0 ft., From 0 ft. to 0 ft.  
 GRAVEL PACK INTERVALS: From 23 ft. to 70 ft., From 0 ft. to 0 ft.  
 From 0 ft. to 0 ft., From 0 ft. to 0 ft.

6 GROUT MATERIAL BENTONITE  
 Grout Intervals: From 0 ft. to 23 ft., From 0 ft. to 0 ft., From 0 ft. to 0 ft.  
 What is the nearest source of possible contamination: SEPTIC TANK  
 Direction from well? EAST How many feet? 5500

FROM	TO	LITHOLOGIC LOG	FROM	TO	PLUGGING INTERVALS
0	8	SILT AND SAND			
8	66	SAND AND GRAVEL			
66	70	TAN CLAY			

7 CONTRACTOR'S OR LANDOWNER'S CERTIFICATION: This water well was Constructed under my jurisdiction and was completed on (mo/day/year) 08/12/03 and this record is true to the best of my knowledge and belief Kansas Water Well Contractor's License No. 653A This Water Well Record was completed on (mo/day/yr) 10/10/03 under the business name of DAN HAYSE WATER WELL SVC. by (signature) Dan Hayse