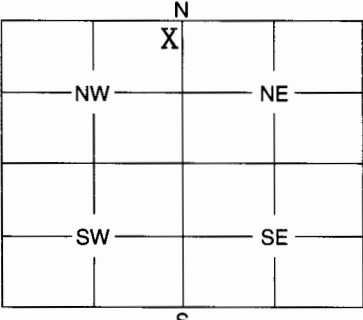


1 LOCATION OF WATER WELL: Fraction Section Number Township Number Range Number
 County: Edwards NE 1/4 NW 1/4 NW 1/4 28 24 18 5/W
 Distance and direction from nearest town or city street address of well if located within city?
2 1/2 West of Lewis

2 WATER WELL OWNER: Marlin Butler
RR2 Box 65B
 RR #, St. Address, Box #: Lewis, Ks 67552
 City, State, ZIP Code : Lewis, Ks 67552
 Board of Agriculture, Division of Water Resources
 Application Number: _____

3 MARK WELL'S LOCATION WITH AN "X" IN SECTION BOX:

 4 DEPTH OF WELL 47 ft.
 WELL'S STATIC WATER LEVEL 41 ft.
 WELL WAS USED AS:
 1 Domestic 5 Public Water Supply 9 Dewatering
 2 Irrigation 6 Oil Field Water Supply 10 Monitoring Well
 3 Feedlot 7 Domestic (Lawn & Garden) 11 Injection Well
 4 Industrial 8 Air Conditioning 12 Other
 Was a chemical / bacteriological sample submitted to Department? Yes No X.....
 If yes, mo/day/yr sample was submitted
 Water Well Disinfected: Yes .. HTH No

5 TYPE OF BLANK CASING USED:
 1 Steel 3 RMP (SR) 5 Wrought 7 Fiberglass 9 Other (Specify below)
 2 PVC 4 ABS 6 Asbestos-Cement 8 Concrete Tile
 Blank casing diameter 5 in. Was casing pulled? Yes No X..... If yes, how much
 Casing height above or below land surface 72 in.

6 GROUT PLUG MATERIAL: 1 Neat cement 2 Cement grout 3 Bentonite 4 Other hole plug
 Grout Plug Intervals: From 8 ft. to 6 ft., From ft. to ft., From 47 to 8 ft.
 What is the nearest source of possible contamination:
 1 Septic tank 6 Seepage pit 11 Fuel storage 16 Other (specify below)
 2 Sewer lines 7 Pit privy 12 Fertilizer storage House
 3 Watertight sewer lines 8 Sewage lagoon 13 Insecticide storage
 4 Lateral lines 9 Feedyard 14 Abandoned water well
 5 Cess pool 10 Livestock pens 15 Oil well/Gas well
 Direction from well? ... East How many feet? ... 100

FROM	TO	PLUGGING MATERIALS
<u>47</u>	<u>8</u>	<u>Hole plug</u>
<u>8</u>	<u>6</u>	<u>Cement</u>

7 CONTRACTOR'S OF LANDOWNER'S CERTIFICATION: This water well was plugged under my jurisdiction and was completed on (mo/day/year) 12-28-06 and this record is true to the best of my knowledge and belief. Kansas Water Well Contractor's License No. 134 This Water Well Record was completed on (mo/day/year) 1-2-07 under the business name of Rosencrantz- Bemis by (signature) [Signature]

INSTRUCTIONS: Use typewriter or ball point pen. Please press firmly and print clearly. Please fill in blanks, underline or circle the correct answers. Send top three copies to Kansas Department of Health and Environment, Bureau of Water, Geology Section, 1000 SW Jackson St., Ste. 420, Topeka, Kansas 66612-1367. Telephone: 785/296-5522. Send one to Water Well Owner and retain one for your records.