

mw-3

WATER WELL RECORD


Form WWC-5

Division of Water Resources App. No.

1 LOCATION OF WATER WELL: County: Edwards Fraction NE 1/4 SE 1/4 NE 1/4 NW 1/4 Section Number 25 Township No. T 27 S Range Number R 18 E W

Street/Rural Address of Well Location; if unknown, distance & direction from nearest town or intersection: 100 James H. Cross Blvd., Lewis, KS Global Positioning System (GPS) information: Latitude: Longitude: Elevation: Datum: Collection Method: GPS unit (Make/Model): Digital Map/Photo, Topographic Map, Land Survey Est. Accuracy: <3 m, 3-5 m, 5-15 m, >15 m

2 WATER WELL OWNER: Cross Manufacturing, Inc RR#, Street Address, Box #: 11011 King St., Ste # 210 City, State, ZIP Code : Overland Park, KS 66210

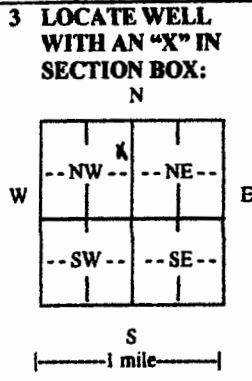

3 LOCATE WELL WITH AN 'X' IN SECTION BOX: 4 DEPTH OF COMPLETED WELL: 54.3 ft. Depth(s) Groundwater Encountered (1) 48.4 ft. (2) ft. (3) ft. WELL'S STATIC WATER LEVEL: ft. below land surface measured on mo/day/yr. Pump test data: Well water was ft. after hours pumping gpm EST. YIELD: gpm. Well water was ft. after hours pumping gpm Bore Hole Diameter 3.25 in. to 54.3 ft., and in. to ft. WELL WATER TO BE USED AS: Public water supply, Geothermal, Injection well, Domestic, Feedlot, Oil field water supply, Dewatering, Other (Specify below), Irrigation, Industrial, Domestic-lawn & garden, Monitoring well Was a chemical/bacteriological sample submitted to Department? Yes No If yes, mo/day/yr sample was submitted. Water well disinfected? Yes No

5 TYPE OF CASING USED: Steel PVC Other CASING JOINTS: Glued Clamped Welded Threaded Casing diameter 1 in. to 54.3 ft., Diameter in. to ft., Diameter in. to ft. Casing height above land surface 0 in., Weight lbs./ft., Wall thickness or gauge No. Schedule 40 TYPE OF SCREEN OR PERFORATION MATERIAL: Steel Stainless Steel PVC Other (Specify) Brass Galvanized Steel None used (open hole) SCREEN OR PERFORATION OPENINGS ARE: Continuous slot Mill slot Gauze wrapped Torch cut Drilled holes None (open hole) Louvered shutter Key punched Wire wrapped Saw cut Other (specify) SCREEN-PERFORATED INTERVALS: From 4.3 ft. to 54.3 ft., From ft. to ft. From ft. to ft. From ft. to ft. GRAVEL PACK INTERVALS: From 4.2 ft. to 54.3 ft., From ft. to ft. From ft. to ft. From ft. to ft.

6 GROUT MATERIAL: Neat cement Cement grout Bentonite Other Grout Intervals: From 0 ft. to 4.2 ft., From ft. to ft., From ft. to ft. What is the nearest source of possible contamination: Septic tank Lateral lines Pit privy Livestock pens Insecticide storage Other (specify below) Sewer lines Cesspool Sewage lagoon Fuel storage Abandoned water well Chrome plating area Watertight sewer lines Seepage pit Feedyard Fertilizer storage Oil well/gas well Direction from well Distance from well 25 S. 4. M. 10-3

Table with columns: FROM, TO, LITHOLOGIC LOG, FROM, TO, LITHO. LOG (cont.) or PLUGGING INTERVALS. Rows contain depth intervals and lithological descriptions like 'Concrete', 'silty clay, clay, silt, silty sand', 'sandy silt', 'fine to coarse sand & gravelly sand'.

7 CONTRACTOR'S OR LANDOWNER'S CERTIFICATION: This water well was constructed, reconstructed, or plugged under my jurisdiction and was completed on (mo/day/year) 8/16/12 and this record is true to the best of my knowledge and belief. Kansas Water Well Contractor's License No. 604 This Water Well Record was completed on (mo/day/year) 9/4/12 under the business name of Environmental Priority Service, Inc. by (signature) P. H. A. M. T.

INSTRUCTIONS: Use typewriter or ball point pen. PLEASE PRESS FIRMLY and PRINT clearly. Please fill in blanks and check the correct answers. Send three copies (white, blue, pink) to Kansas Department of Health and Environment, Bureau of Water, Geology Section, 1000 SW Jackson St., Suite 420, Topeka, Kansas 66612-1367. Telephone 785-296-5524. Send one copy to WATER WELL OWNER and retain one for your records. Include fee of \$5.00 for each constructed well. Visit us at http://www.kdheks.gov/waterwell/index.html.