


WATER WELL RECORD Form WWC-5 KSA 82a-1212

1 LOCATION OF WATER WELL: Fraction Section Number Township Number Range Number
 COUNTY: EDWARDS SE 1/4 SE 1/4 NE 1/4 25 T 24 S R 18 E

Distance and direction from nearest town or city street address of well if located within city?
 FROM LEWIS - 1/2 MILE EAST AND 1/2 MILE SOUTH

2 WATER WELL OWNER: BELL, JOHN
 RR#, St. Address, Box #: BOX 5
 City, State, ZIP code: LEWIS, KS 67552- Board of Agriculture, Division of Water Resources
 Application Number:

3 LOCATE WELL'S LOCATION WITH AN "X" IN SECTION BOX:

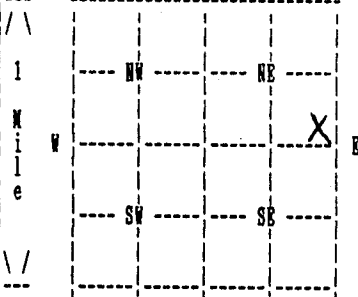

4 DEPTH OF COMPLETED WELL 100 ELEVATION: 0
 Depth(s) Groundwater Encountered 1. 0 ft. 2. 0 ft. 3. 0 ft.

WELL'S STATIC WATER LEVEL 40 ft. below land surface measured on no/day/yr 06/17/94
 Pump test data: Well water was 0 ft. after 0 hours pumping 0 gpm

Estimated Yield 65 gpm: Well water was 0 ft. after 0 hours pumping 0 gpm

Bore Hole Diameter 8 in. to 100 ft., and in. to 0 ft.

WELL WATER TO BE USED AS: LAWN & GARDEN

Was a chemical/bacteriological sample submitted to department? No;
 If yes, no/day/yr sample was submitted Water well disinfected? Yes

5 TYPE OF BLANK CASING USED: PVC CASING JOINTS: GLOUED
 Blank casing diameter 5 in. to 100 ft., Dia in. to 0 ft., Dia in. to 0 ft.
 Casing height above land surface 12 in., weight 200 lbs/ft. Wall thickness or gauge No. 21
 TYPE OF SCREEN OR PERFORATION MATERIAL: PVC
 SCREEN OR PERFORATION OPENINGS ARE: SAW CUT

SCREEN PERFORATED INTERVALS: From 55 ft. to 95 ft., From 0 ft. to 0 ft.
 From 0 ft. to 0 ft., From 0 ft. to 0 ft.
 GRAVEL PACK INTERVALS: From 40 ft. to 100 ft., From 0 ft. to 0 ft.
 From 0 ft. to 0 ft., From 0 ft. to 0 ft.

6 GROUT MATERIAL BENTONITE
 Grout intervals: From 5 ft. to 40 ft., From 0 ft. to 0 ft., From 0 ft. to 0 ft.
 What is the nearest source of possible contamination: SEPTIC TANK
 Direction from well? SOUTH How many feet? 175

FROM	TO	LITHOLOGIC LOG	FROM	TO	PLUGGING INTERVALS
0	15	TOPSOIL SAND CLAY			
15	20	SAND GRAVEL			
20	25	CLAY			
25	85	SAND GRAVEL			
85	95	SANDY CLAY			
95	100	GRAY CLAY			

7 CONTRACTOR'S OR LANDOWNER'S CERTIFICATION: This water well was Constructed under my jurisdiction and was completed on (no/day/year) 06/20/94 and this record is true to the best of my knowledge and belief. Kansas Water Well Contractor's License No. 179 This Water Well Record was completed on (no/day/yr) 06/28/94 under the business name of JOE'S WELL SERVICE, INC. by (signature) *Joel Crisk*