


WATER WELL RECORD Form WWC-5 KSA 82a-1212

1 LOCATION OF WATER WELL: Fraction Section Number Township Number Range Number
 COUNTY: 024 EDWARDS SW 1/4 SW 1/4 NW 1/4 27 T 24 S R 19 W

Distance and direction from nearest town or city street address of well if located within city?
 101 S. NILES KINSLEY, KS 67547-

2 WATER WELL OWNER: DON STEELE, SR. 338 Board of Agriculture, Division of Water Resources
 RR#, St. Address, Box #: P.O. BOX 116
 City, State, ZIP code: FORGAN, OK 73938- Application Number:

3 LOCATE WELL'S LOCATION WITH AN "X" IN SECTION BOX:

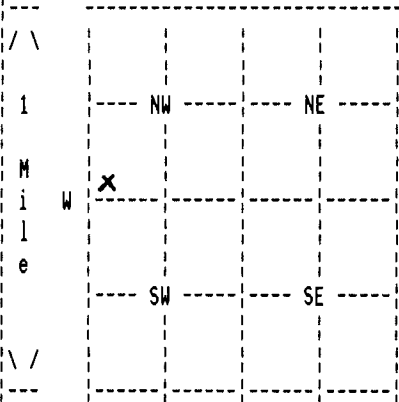

4 DEPTH OF COMPLETED WELL 12 ELEVATION: 0
 Depth(s) Groundwater Encountered 1. 8 ft. 2. 0 ft. 3. 0 ft.
 WELL'S STATIC WATER LEVEL 8 ft. below land surface measured on mo/day/yr
 Pump testdata: Well water was 0 ft. after 0 hours pumping 0 gpm
 Estimated Yield 0 gpm: Well water was 0 ft. after 0 hours pumping 0 gpm
 Bore Hole Diameter 6 in. to 12 ft., and in. to 0 ft.
 WELL WATER TO BE USED AS: 01 DOMESTIC
 Was a chemical/bacteriological sample submitted to department? No ;
 If yes, mo/day/yr sample was submitted Water well disinfected? Yes

5 TYPE OF BLANK CASING USED: 01 STEEL CASING JOINTS: WELDED
 Blank casing diameter 6 in. to 12 ft., Dia in. to 0 ft., Dia in. to 0 ft.
 Casing height above land surface 0 in., weight 0 lbs/ft. Wall thickness or gauge No.
 TYPE OF SCREEN OR PERFORATION MATERIAL: 01 STEEL
 SCREEN OR PERFORATION OPENINGS ARE: 07 TORCH CUT

SCREEN PERFORATED INTERVALS: From 0 ft. to 0 ft., From 0 ft. to 0 ft.
 From 0 ft. to 0 ft., From 0 ft. to 0 ft.
 GRAVEL PACK INTERVALS: From 0 ft. to 0 ft., From 0 ft. to 0 ft.
 From 0 ft. to 0 ft., From 0 ft. to 0 ft.

6 GROUT MATERIAL 03 BENTONITE
 Grout Intervals: From 3 ft. to 8 ft., From 0 ft. to 0 ft., From 0 ft. to 0 ft.
 What is the nearest source of possible contamination: 02 SEWER LINES
 Direction from well? W How many feet? 60

FROM	TO	LITHOLOGIC LOG	FROM	TO	PLUGGING INTERVALS
			12	8	SAND & GRAVEL
			8	3	HOLE PLUG
			3	0	EARTH
			0	0	
			0	0	
			0	0	
			0	0	
			0	0	
			0	0	
			0	0	

7 CONTRACTOR'S OR LANDOWNER'S CERTIFICATION: This water well was Plugged under my jurisdiction and was completed on (mo/day/year) 11/28/95 and this record is true to the best of my knowledge and belief. Kansas Water Well Contractor's License No. 224 This Water Well Record was completed on (mo/day/yr) 11/30/95 under the business name of CARL HAYSE WATER WELL SVC by (signature) *Carl Hayse*