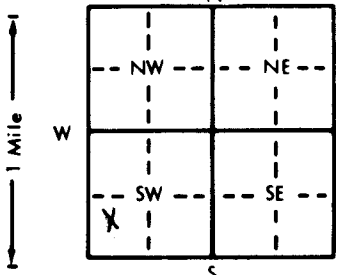


WATER WELL RECORD Form WWC-5 KSA 82a-1212

1 LOCATION OF WATER WELL: Fraction Lot 4 1/4 SW 1/4 SW 1/4 Section Number 31 Township Number T 24 S Range Number R 19 NE/W
 County: Edwards

Distance and direction from nearest town or city street address of well if located within city?
 1 3/4 miles west of Kinsley, Ks.

2 WATER WELL OWNER: Bill Burr
 RR#, St. Address, Box #: Rt. 1- Box 54B Board of Agriculture, Division of Water Resources
 City, State, ZIP Code: Kinsley, Ks. 67547 Application Number: 33,646

3 LOCATE WELL'S LOCATION WITH AN "X" IN SECTION BOX:  DEPTH OF COMPLETED WELL: 121 ft. ELEVATION:
 Depth(s) Groundwater Encountered 1. ft. 2. ft. 3. ft.
 WELL'S STATIC WATER LEVEL 9. ft. below land surface measured on mo/day/yr 8-13-97
 Pump test data: Well water was . ft. after . hours pumping . gpm
 Est. Yield .600. gpm: Well water was .88. ft. after .4. hours pumping .600. gpm
 Bore Hole Diameter .28. in. to .121. ft., and . in. to . ft.
 WELL WATER TO BE USED AS: 5 Public water supply 8 Air conditioning 11 Injection well
 1 Domestic 3 Feedlot 6 Oil field water supply 9 Dewatering 12 Other (Specify below)
 2 Irrigation 4 Industrial 7 Lawn and garden only 10 Monitoring well
 Was a chemical/bacteriological sample submitted to Department? Yes. No. ; If yes, mo/day/yr sample was submitted
 Water Well Disinfected? Yes No

5 TYPE OF BLANK CASING USED: 5 Wrought iron 8 Concrete tile CASING JOINTS: Glued Clamped .
 1 Steel 3 RMP (SR) 6 Asbestos-Cement 9 Other (specify below) Welded .
 2 PVC 4 ABS 7 Fiberglass Threaded .
 Blank casing diameter .16. in. to .21. ft., Dia .16. in. to .41. to .81. ft., Dia . in. to . ft.
 Casing height above land surface .12. in., weight .SDR. 32.5 lbs./ft. Wall thickness or gauge No. .
 TYPE OF SCREEN OR PERFORATION MATERIAL: 7 PVC 10 Asbestos-cement
 1 Steel 3 Stainless steel 5 Fiberglass 8 RMP (SR) 11 Other (specify) .
 2 Brass 4 Galvanized steel 6 Concrete tile 9 ABS 12 None used (open hole)
 SCREEN OR PERFORATION OPENINGS ARE: 5 Gauzed wrapped 8 Saw cut 11 None (open hole)
 1 Continuous slot 3 Mill slot 6 Wire wrapped 9 Drilled holes
 2 Louvered shutter 4 Key punched 7 Torch cut 10 Other (specify) .
 SCREEN-PERFORATED INTERVALS: From .21. ft. to .41. ft., From .81. ft. to .121. ft.
 From . ft. to . ft., From . ft. to . ft.
 GRAVEL PACK INTERVALS: From .121. ft. to .20. ft., From . ft. to . ft.
 From . ft. to . ft., From . ft. to . ft.

6 GROUT MATERIAL: 1 Neat cement 2 Cement grout 3 Bentonite 4 Other .
 Grout Intervals: From .20. ft. to .0. ft., From . ft. to . ft., From . ft. to . ft.
 What is the nearest source of possible contamination:
 1 Septic tank 4 Lateral lines 7 Pit privy 10 Livestock pens 14 Abandoned water well
 2 Sewer lines 5 Cess pool 8 Sewage lagoon 11 Fuel storage 15 Oil well/Gas well
 3 Watertight sewer lines 6 Seepage pit 9 Feedyard 12 Fertilizer storage 16 Other (specify below) none
 13 Insecticide storage .
 Direction from well? How many feet?

FROM	TO	LITHOLOGIC LOG	FROM	TO	PLUGGING INTERVALS
0	3	Top soil	106	112	Brown clay
3	14	Brown clay	112	121	Sand and gravel w/ clay streaks
14	28	Sand and gravel coarse			
28	32	yellow & gray clay			
32	35	Sand and gravel w/clay mixed			
35	45	Brown clay			
45	53	Sandy brown clay			
53	55	Sand and gravel w/ brown clay			
55	73	Brown clay			
73	74	Sand and gravel gray clay mixed			
74	85	Sand and gravel -good			
85	93	Sand w/ clay mixed			
93	95	Fine sand			
95	100	Sand and gravel			
100	106	Sand and gravel streaks of clay			

7 CONTRACTOR'S OR LANDOWNER'S CERTIFICATION: This water well was (1) constructed, (2) reconstructed, or (3) plugged under my jurisdiction and was completed on (mo/day/year) 9-17-97 and this record is true to the best of my knowledge and belief. Kansas Water Well Contractor's License No. 134 This Water Well Record was completed on (mo/day/yr) 10-3-97 under the business name of Rosencrantz-Bemis by (signature) Fredie Hedson

INSTRUCTIONS: Use typewriter or ball point pen. PLEASE PRESS FIRMLY and PRINT clearly. Please fill in blanks, underline or circle the correct answers. Send top three copies to Kansas Department of Health and Environment, Bureau of Water, Topeka, Kansas 66620-0001. Telephone: 913-296-5545. Send one to WATER WELL OWNER and retain one for your records.

OFFICE USE ONLY
T
R
EW
SEC
1/4
1/4