


1	LOCATION OF WATER WELL:	Fraction	Section Number	Township Number	Range Number
County:	Edwards	NW¼ NE¼ NE¼	33	24S	19W

Distance and direction from nearest town or city street address of well if located within city?
 Junction Hwy 183 + 86 Kinsley

2	WATER WELL OWNER:	Western Resources	Board of Agriculture, Division of Water Resources
RR #, St. Address, Box #:	P.O. Box 889	Application Number:	
City, State, ZIP Code :	Topeka Kansas 66601		

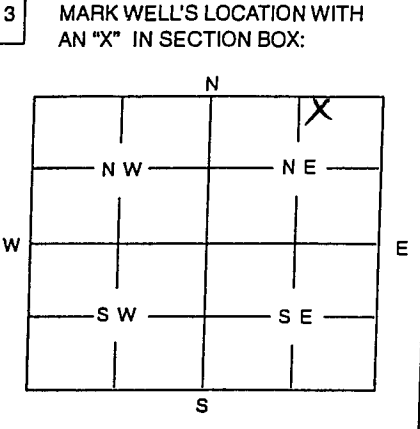

4	DEPTH OF WELL 15 ft	
	WELL'S STATIC WATER LEVEL 10 ft.	
WELL WAS USED AS:		
1 Domestic	5 Public Water Supply	9 Dewatering
2 Irrigation	6 Oil Field Water Supply	<input checked="" type="checkbox"/> Monitoring Well
3 Feedlot	7 Domestic (Lawn & Garden)	11 Injection Well
4 Industrial	8 Air Conditioning	12 Other
Was a chemical / bacteriological sample submitted to Department? Yes No <input checked="" type="checkbox"/>		
If yes, mo/day/yr sample was submitted		
Water Well Disinfected: Yes No <input checked="" type="checkbox"/>		

5 TYPE OF BLANK CASING USED:

1 Steel	3 RMP (SR)	5 Wrought	7 Fiberglass	9 Other (Specify below)
<input checked="" type="checkbox"/> PVC	4 ABS	6 Asbestos-Cement	8 Concrete Tile	

Blank casing diameter in. Was casing pulled? Yes No

Casing height above or below land surface + 32.4 in. If yes, how much

6 GROUT PLUG MATERIAL: 1 Neat cement 2 Cement grout 3 Bentonite 4 Other

Grout Plug Intervals: From 0 ft. to 15 ft., From ft. to ft., From to ft.

What is the nearest source of possible contamination:

1 Septic tank	6 Seepage pit	11 Fuel storage
2 Sewer lines	7 Pit privy	12 Fertilizer storage
3 Watertight sewer lines	8 Sewage lagoon	13 Insecticide storage
4 Lateral lines	9 Feedyard	14 Abandoned water well
5 Cess Pool	10 Livestock pens	15 Oil well/Gas well

Direction from well? S How many feet? 350

Other (specify below) former well

FROM	TO	PLUGGING MATERIALS
0	10	8" Bentonite
10	15	2" Bentonite
		MW 13

7 CONTRACTOR'S OR LANDOWNER'S CERTIFICATION: This water well was plugged under my jurisdiction and was completed on (mo/day/year) 5-18-2000 and this record is true to the best of my knowledge and belief. Kansas Water Well Contractor's License No. 527 This Water Well Record was completed on (mo/day/year) 6-13-2000 under the business name of BeeCore Services, Inc by (signature) [Signature]

INSTRUCTIONS: Use typewriter or ball point pen. Please press firmly and print clearly. Please fill in blanks, underline or circle the correct answers. Send top three copies to Kansas Department of Health and Environment, Bureau of Water, Topeka, Kansas 66620-0001. Telephone: 785/296-3565. Send one to Water Well Owner and retain one for your records.