


1	LOCATION OF WATER WELL:	Fraction	Section Number	Township Number	Range Number
	County: <u>Edwards</u>	<u>S 1/4 N 1/4 NE 1/4</u>	<u>33</u>	<u>24S</u>	<u>19W</u>

Distance and direction from nearest town or city street address of well if located within city?
4th + Colony Streets, Kinsley

2	WATER WELL OWNER:	RR #, St. Address, Box #:	City, State, ZIP Code :	Board of Agriculture, Division of Water Resources	Application Number:
	<u>Kinsley Cooperative Exchange</u>	<u>4th + Colony Streets</u>	<u>Kinsley, Kansas, 67547</u>		

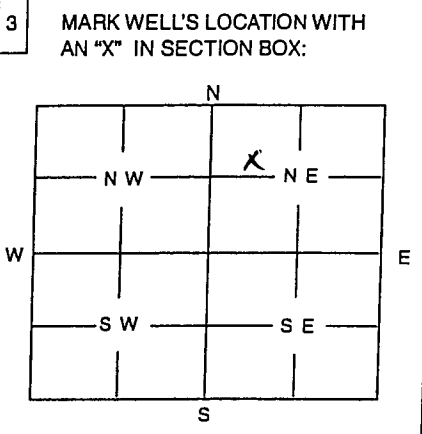

4	DEPTH OF WELL	<u>17.5</u> ft
	WELL'S STATIC WATER LEVEL	<u>10.70</u> ft.
	WELL WAS USED AS:	
	1 Domestic	5 Public Water Supply
	2 Irrigation	6 Oil Field Water Supply
	3 Feedlot	7 Domestic (Lawn & Garden)
	4 Industrial	8 Air Conditioning
		9 Dewatering
		10 <input checked="" type="checkbox"/> Monitoring Well
		11 Injection Well
		12 Other

Was a chemical / bacteriological sample submitted to Department? Yes No X
 If yes, mo/day/yr sample was submitted

Water Well Disinfected: Yes No X

5 TYPE OF BLANK CASING USED:

1 Steel	3 RMP (SR)	5 Wrought	7 Fiberglass	9 Other (Specify below)
<input checked="" type="checkbox"/> 2 PVC	4 ABS	6 Asbestos-Cement	8 Concrete Tile	

Blank casing diameter 2 in. Was casing pulled? Yes No X If yes, how much in.

6 GROUT PLUG MATERIAL: 1 Neat cement 2 Cement grout 3 Bentonite 4 Other

Grout Plug Intervals: From 0 ft. to 20 ft., From ft. to ft., From to ft.

What is the nearest source of possible contamination:

1 Septic tank	6 Seepage pit	<input checked="" type="checkbox"/> 11 Fuel storage	16 Other (specify below)
2 Sewer lines	7 Pit privy	12 Fertilizer storage	
3 Watertight sewer lines	8 Sewage lagoon	13 Insecticide storage	
4 Lateral lines	9 Feedyard	14 Abandoned water well	
5 Cess Pool	10 Livestock pens	15 Oil well/Gas well	

Direction from well? East How many feet? 140

FROM	TO	PLUGGING MATERIALS
<u>0</u>	<u>20</u>	<u>8" Bentonite</u>

Bmw-6

7 CONTRACTOR'S OR LANDOWNER'S CERTIFICATION: This water well was plugged under my jurisdiction and was completed on (mo/day/year) 5-18-2000 and this record is true to the best of my knowledge and belief. Kansas Water Well Contractor's License No. 227 This Water Well Record was completed on (mo/day/year) 6-13-2000 under the business name of Geolore Services Inc by (signature) [Signature]

INSTRUCTIONS: Use typewriter or ball point pen. Please press firmly and print clearly. Please fill in blanks, underline or circle the correct answers. Send top three copies to Kansas Department of Health and Environment, Bureau of Water, Topeka, Kansas 66620-0001. Telephone: 785/296-3565. Send one to Water Well Owner and retain one for your records.