


1	LOCATION OF WATER WELL:	Fraction	Section Number	Township Number	Range Number
	County: <u>Edwards</u>	<u>NW 1/4 NE 1/4 SW 1/4</u>	<u>33</u>	<u>T 24 S</u>	<u>R 19 W</u>

Distance and direction from nearest town or city street address of well if located within city?  
Northeast corner of 9th + Highway 50

2 WATER WELL OWNER: Kinsky Ready Mix, Inc.  
 RR #, St. Address, Box #: RR 1, Box 45  
 City, State, ZIP Code: Kinsky, Kansas  
 Board of Agriculture, Division of Water Resources  
 Application Number: \_\_\_\_\_

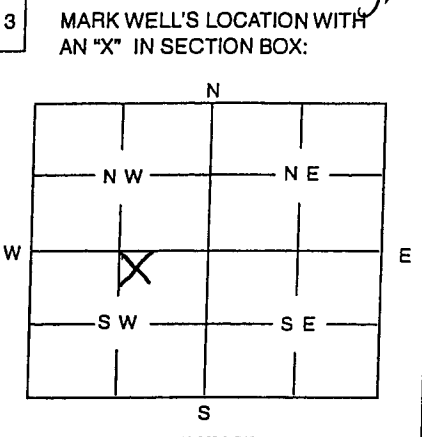

4 DEPTH OF WELL ..... 17 ..... ft  
 WELL'S STATIC WATER LEVEL 10.78 ft.  
 WELL WAS USED AS:  
 1 Domestic                      5 Public Water Supply                      8 Dewatering  
 2 Irrigation                      6 Oil Field Water Supply                      10 Monitoring Well  
 3 Feedlot                      7 Domestic (Lawn & Garden)                      11 Injection Well  
 4 Industrial                      8 Air Conditioning                      12 Other .....

Was a chemical / bacteriological sample submitted to Department? Yes ..... No   
 If yes, mo/day/yr sample was submitted .....

Water Well Disinfected: Yes ..... No

5 TYPE OF BLANK CASING USED:  
 1 Steel      3 RMP (SR)      5 Wrought      7 Fiberglass      9 Other (Specify below)  
 2 PVC      4 ABS      6 Asbestos-Cement      8 Concrete Tile .....

Blank casing diameter ..... 2 ..... in.      Was casing pulled? Yes ..... No       If yes, how much .....

Casing height above or below land surface ..... 0 ..... in.

6 GROUT PLUG MATERIAL:      1 Neat cement      2 Cement grout      3 Bentonite      4 Other Native Soil  
 Grout Plug Intervals:      From 1 ft. to 17 ft.,      From 0 ft. to 1 ft.,      From ..... to ..... ft.

What is the nearest source of possible contamination:  
 1 Septic tank                      6 Seepage pit                      11 Fuel storage                      16 Other (specify below)  
 2 Sewer lines                      7 Pit privy                      12 Fertilizer storage .....

3 Watertight sewer lines                      8 Sewage lagoon                      13 Insecticide storage .....

4 Lateral lines                      9 Feedyard                      14 Abandoned water well .....

5 Cess Pool                      10 Livestock pens                      15 Oil well/Gas well .....

Direction from well? excavation      How many feet? 0

FROM	TO	PLUGGING MATERIALS
<u>0</u>	<u>1</u>	<u>Native Soil</u>
<u>1</u>	<u>15</u>	<u>Bentonite (8")</u>
<u>15</u>	<u>17</u>	<u>Bentonite (2")</u>

MWI

7 CONTRACTOR'S OR LANDOWNER'S CERTIFICATION: This water well was plugged under my jurisdiction and was completed on (mo/day/year) 5/14/00 and this record is true to the best of my knowledge and belief. Kansas Water Well Contractor's License No. 327  
6/6/00 under the business name of Geolark Services, Inc.  
 by (signature) Don Kalk

INSTRUCTIONS: Use typewriter or ball point pen. Please press firmly and print clearly. Please fill in blanks, underline or circle the correct answers. Send top three copies to Kansas Department of Health and Environment, Bureau of Water, Topeka, Kansas 66620-0001. Telephone: 785/296-3565. Send one to Water Well Owner and retain one for your records.