


1	LOCATION OF WATER WELL:	Fraction	Section Number	Township Number	Range Number
	County: <u>Edwards</u>	<u>NW 1/4 NE 1/4 SW 1/4</u>	<u>33</u>	<u>T 24 S</u>	<u>R 19 W</u>

Distance and direction from nearest town or city street address of well if located within city?
Northeast corner of 9th + Highway 50

2 WATER WELL OWNER: Kinsky Ready Mix
 RR #, St. Address, Box #: RR1, Box 45
 City, State, ZIP Code: Kinsky, Kansas
 Board of Agriculture, Division of Water Resources
 Application Number: _____

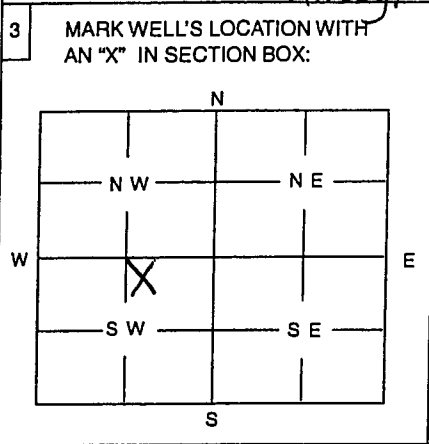

5 TYPE OF BLANK CASING USED:
 Steel 3 RMP (SR) 5 Wrought 7 Fiberglass 9 Other (Specify below)
 PVC 4 ABS 6 Asbestos-Cement 8 Concrete Tile

Blank casing diameter 2 in. Was casing pulled? Yes No
 Casing height above or below land surface 29 in. If yes, how much

6 GROUT PLUG MATERIAL: 1 Neat cement 2 Cement grout Bentonite Other Native Soil
 Grout Plug Intervals: From 1 ft. to 20 ft., From 0 ft. to 1 ft., From to ft.

What is the nearest source of possible contamination:
 1 Septic tank 6 Seepage pit 11 Fuel storage 16 Other (specify below)
 2 Sewer lines 7 Pit privy 12 Fertilizer storage
 3 Watertight sewer lines 8 Sewage lagoon 13 Insecticide storage
 4 Lateral lines 9 Feedyard 14 Abandoned water well
 5 Cess Pool 10 Livestock pens 15 Oil well/Gas well

Direction from well? How many feet?

FROM	TO	PLUGGING MATERIALS
<u>0</u>	<u>1</u>	<u>Native Soil</u>
<u>1</u>	<u>20</u>	<u>Bentonite (8")</u>

EXMW

7 CONTRACTOR'S OR LANDOWNER'S CERTIFICATION: This water well was plugged under my jurisdiction and was completed on (mo/day/year) 5/12/00 and this record is true to the best of my knowledge and belief. Kansas Water Well Contractor's License No. 527 This Water Well Record was completed on (mo/day/year) 6/16/00 under the business name of Geo Care Services, Inc. by (signature) [Signature]

INSTRUCTIONS: Use typewriter or ball point pen. Please press firmly and print clearly. Please fill in blanks, underline or circle the correct answers. Send top three copies to Kansas Department of Health and Environment, Bureau of Water, Topeka, Kansas 66620-0001. Telephone: 785/296-3565. Send one to Water Well Owner and retain one for your records.